

**BAY COUNTY REMONUMENTATION 1999
LAND CORNER RECORDATION CERTIFICATE**
Filing Requirement of Act 74, Mich. P.A. 1970

SECTION

For corners in

BAY
(County)

MERRITT TOWNSHIP

Located in: Corner Code #

- | | | |
|-------------------------|--------------------------|-------------|
| 1. Public Land Survey | T <u>13N</u> R <u>6E</u> | <u>I-11</u> |
| | T _____ R _____ | _____ |
| 2. Property Controlling | S _____ T _____ R _____ | _____ |
| 3. Miscellaneous | S _____ T _____ R _____ | _____ |
| Property in Sec. | S _____ T _____ R _____ | _____ |

RECORDED

1999 DEC 29 P 12:51

REGISTER OF DEEDS
BAY COUNTY, MICHIGAN

Register of Deeds Stamp & File Number

4. Lot No. _____, Recorded Plat _____
5. Private Claims _____

I, BRIAN D FERGUSON, in a field survey on MAY, 19 99 do hereby state that under requirements of P.A. 74, Michigan P.A. of 1970, the corner points mentioned in lines 1 and 2 above were in conformance with regulations and rules therefore as required in the current manual of survey instructions of the United States Department of the Interior, Bureau of Land Management or by a decree of a Court of Law and/or that the corner points mentioned in lines 3, 4 and 5 above were in conformance with the rules of the Michigan Board of Land Surveyors or by a Decree of a Court of Law; established, re-established, monumented, recovered, found as expressed below:

A	B	C	D	E	F	G	H	I	J	K	L	M
2	6	5	4	3	2							
3												
4	7	8	9	10	11	12						
5												
6	18	17	16	15	14	13						
7												
8	19	20	21	22	23	24						
9												
10	30	29	28	27	26	25						
11												
12	31	32	33	34	35	36						
13												

NOTE: Not more than 2 corners, all in the same town and range, may be recorded on this certificate.

A. Description of original monument and accessories and/or subsequent restoration:

WOOD POST SET BY J. WAMPLER, DS, IN 1821. NO EVIDENCE OF ORIGINAL CORNER REMAINS.
LCRC BY LEACH, L001 P571, IN 1973
LCRC BY MCGINNIS, L002 P143, IN 1974
COS BY MCGINNIS, L853 P601
UNRECORDED SURVEY BY RC ENGINEERING IN 1986

B. Description of corner evidence found and/or method applied in restoring or reestablishing corner:


FOUND 1" IRON PIPE PER LCRC'S AND UNRECORDED SURVEY
MEASURED 2619.73' TO J-11 (UNRECORDED SURVEY 2619.92')

ACCEPTED AS THE BEST AVAILABLE EVIDENCE OF THE LOCATION OF THE ORIGINAL CORNER

C. Description of monument for corner and accessories established to perpetuate locating the position of the corner:

SET 5/8" RE-BAR W / BAY COUNTY REMON. BRASS CAP & NO. 26454 IN MONUMENT BOX
WEST 95.5' CTR LINE RR TRACKS (REC 95.5')
N30W 68.80' STOP SIGN POST
S15W 32.68' FCE PWR POLE (REC 32.8')
S45W 15.70' E LEG SIGN POST
S85W 90.66' CTR SOUTH END RR CROSSING SIGN (REC 90.66')

Signed by Brian D Ferguson Date December 15, 1999
Surveyor's Michigan License No. 26454

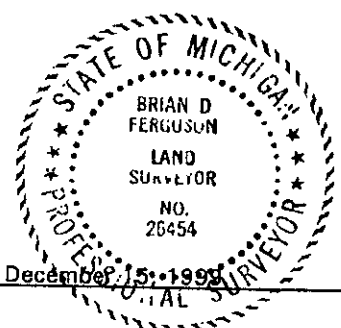

APPROVED LAND CORNER
P.A. 345 OF 1990 - Bay County
Date 8.05.99
MM
Michael MacDonald P.S.
County Representative

FORM APPROVED BY MICHIGAN STATE BOARD OF PROFESSIONAL SURVEYORS, JAN. 28, 1971
REVISED MAY 14, 1975
REVISED JAN., 1983
REVISED OCT., 1995

004 328