

SECTION

BAY COUNTY REMONUMENTATION 1999
LAND CORNER RECORDATION CERTIFICATE
Filing Requirement of Act 74, Mich. P.A. 1970

For corners in

<u>BAY</u> (County)	Located in:	MERRITT TOWNSHIP	Corner Code #
1. Public Land Survey	T <u>13N</u> R <u>6E</u>		<u>I-12</u>
2. Property Controlling	T _____ R _____		_____
3. Miscellaneous	S _____ T _____ R _____		_____
Property in Sec.	S _____ T _____ R _____		_____

1999 DEC 29 P 12: 51
 REGISTER OF DEEDS
 BAY COUNTY, MICHIGAN

RECORDED

Register of Deeds Stamp & File Number

4. Lot No. _____, Recorded Plat _____
5. Private Claims _____

I, BRIAN D. FERGUSON, in a field survey on MAY, 19 99 do hereby state that under requirements of P.A. 74, Michigan P.A. of 1970, the corner points mentioned in lines 1 and 2 above were in conformance with regulations and rules therefore as required in the current manual of survey instructions of the United States Department of the Interior, Bureau of Land Management or by a decree of a Court of Law and/or that the corner points mentioned in lines 3, 4 and 5 above were in conformance with the rules of the Michigan Board of Land Surveyors or by a Decree of a Court of Law; established, re-established, monumented, recovered, found as expressed below:

1	A	B	C	D	E	F	G	H	I	J	K	L	M
2		6		5		4		3		2			
3													
4		7		8		9		10		11		12	
5													
6		18		17		16		15		14		13	
7													
8		19		20		21		22		23		24	
9													
10		30		29		28		27		26		25	
11													
12		31		32		33		34		35		36	
13													

NOTE: Not more than 2 corners, all in the same town and range, may be recorded on this certificate.

A. Description of original monument and accessories and/or subsequent restoration:

WOOD POST SET BY J. WAMPLER, DS, IN 1821. NO EVIDENCE OF ORIGINAL CORNER REMAINS.
 NO LCRC FOR THIS CORNER
 COS BY MCGINNIS, L853 P601
 COS BY MACDONALD, L832 P151

B. Description of corner evidence found and/or method applied in restoring or reestablishing corner:

FOUND 3/4" PIPE PER COS
 PIPE IS ON LINE, ON A SPLIT BETWEEN I-13 AND I-11

ACCEPTED AS THE BEST AVAILABLE EVIDENCE OF THE LOCATION OF THE ORIGINAL CORNER


C. Description of monument for corner and accessories established to perpetuate locating the position of the corner:

SET 5/8" RE-BAR W / BAY COUNTY REMON. BRASS CAP & NO. 26454 IN MONUMENT BOX
 N40E 61.73' NAIL & FLAG SE FCE PWR POLE (REC 61.2' TO TAG IN PWR POLE)
 N55E 42.40' CTR ROAD/STOP SIGN
 S80W 34.05' BTM CTR STOP SIGN
 S40W 46.98' TOP CTR AMER RISER

Signed by Brian D Ferguson

Date December 15, 1999

Surveyor's Michigan License No. 26454

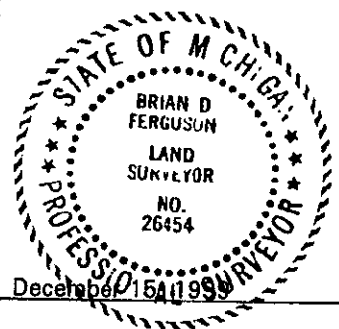

APPROVED LAND CORNER
 P.A. 345 OF 1990 - Bay County
 Date 209.99
MM
 Michael MacDonald P.S.

FORM APPROVED BY MICHIGAN STATE BOARD OF PROFESSIONAL SURVEYORS, JAN. 28, 1971
 REVISED MAY 14, 1975
 REVISED JAN., 1983
 REVISED OCT., 1995

004 327