SECTION

BAY COUNTY REMONUMENTATION 1999
LAND CORNER RECORDATION CERTIFICATE
Filing Requirement of Act 74, Mich. P.A. 1970

For corners in

BAY (County)

MERRITT TOWNSHIP

Located in: Corner Code #

1. Public Land Survey T 13N R 6E — I-13
   T ___ R ___
2. Property Controlling S ___ T ___ R ___
3. Miscellaneous Property in Sec. S ___ T ___ R ___

RECORDED
1999 DEC 29 P 12: 51
Barbara Forbes McFarlane
REGISTER OF DEEDS
BAY COUNTY, MICHIGAN

Register of Deeds Stamp & File Number

4. Lot No. ___, Recorded Plat ___
5. Private Claims ___

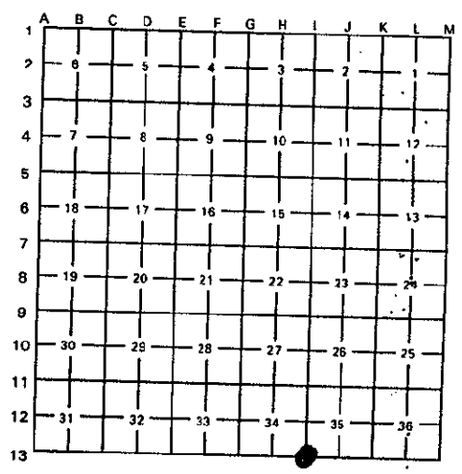

I, BRIAN D FERGUSON, in a field survey on MAY, 19 99 do hereby state that under requirements of P.A. 74, Michigan P.A. of 1970, the corner points mentioned in lines 1 and 2 above were in conformance with regulations and rules therefore as required in the current manual of survey instructions of the United States Department of the Interior, Bureau of Land Management or by a decree of a Court of Law and/or that the corner points mentioned in lines 3, 4 and 5 above were in conformance with the rules of the Michigan Board of Land Surveyors or by a Decree of a Court of Law; established, re-established, monumented, recovered, found as expressed below:

NOTE: Not more than 2 corners, all in the same town and range, may be recorded on this certificate.

A. Description of original monument and accessories and/or subsequent restoration:

WOOD POST SET BY J. WAMPLER, DS, IN 1821. NO EVIDENCE OF ORIGINAL CORNER REMAINS.
COS BY FOKENS, L929 P827 (NO WITNESSES REMAIN)

B. Description of corner evidence found and/or method applied in restoring or reestablishing corner:

FOUND 3/4" PIPE AT INTERSECTION OF I-11, I-12 EXTENDED S'LY WITH H-13, J-13
MEASURED 2634.80' TO H-13, REC 2635.05

ACCEPTED AS THE BEST AVAILABLE EVIDENCE OF THE LOCATION OF THE ORIGINAL CORNER

C. Description of monument for corner and accessories established to perpetuate locating the position of the corner:

SET 5/8" RE-BAR W / BAY COUNTY REMON. BRASS CAP & NO. 26454 IN MONUMENT BOX
SOUTH 5.90' W LEG DIRECTIONAL SIGN
N50E 48.15' W LEG DIRECTIONAL SIGN
S60E 54.95' BTM CTR STREET SIGN
EAST 36.95' BRASS CAP, I-1, T12N-R6E (REC GLO CALL IS 36.96')

Signed by Brian D Ferguson — Date December 15, 1999

Surveyor's Michigan License No. 26454

STATE OF MICHIGAN
BRIAN D FERGUSON
LAND SURVEYOR
NO. 26454
PROFESSIONAL SURVEYOR

APPROVED LAND CORNER
P.A. 345 OF 1990 - Bay County
Date 11.18.99
MM
Michael MacDonald P.S.
County Representative

FORM APPROVED BY MICHIGAN STATE BOARD OF PROFESSIONAL SURVEYORS, JAN. 28, 1971
REVISED MAY 14, 1975
REVISED JAN., 1983
REVISED OCT., 1995