

**BAY COUNTY REMONUMENTATION 1999  
LAND CORNER RECORDATION CERTIFICATE  
Filing Requirement of Act 74, Mich. P.A. 1970**

For corners in SECTION

**MERRITT TOWNSHIP**

<u>BAY</u> (County)	Located in:	Corner Code #
1. Public Land Survey	T <u>13N</u> R <u>6E</u>	<u>J-11</u>
	T _____ R _____	_____
2. Property Controlling	S _____ T _____ R _____	_____
3. Miscellaneous	S _____ T _____ R _____	_____
Property in Sec.	S _____ T _____ R _____	_____

*Robert Francis Haslam*  
 REGISTER OF DEEDS  
 BAY COUNTY, MICHIGAN

1999 DEC 29 P 12:51

**RECORDED**

Register of Deeds Stamp & File Number

4. Lot No. \_\_\_\_\_, Recorded Plat \_\_\_\_\_  
 5. Private Claims \_\_\_\_\_

I, BRIAN D FERGUSON, in a field survey on MAY, 19 99 do hereby state that under requirements of P.A. 74, Michigan P.A. of 1970, the corner points mentioned in lines 1 and 2 above were in conformance with regulations and rules therefore as required in the current manual of survey instructions of the United States Department of the Interior, Bureau of Land Management or by a decree of a Court of Law and/or that the corner points mentioned in lines 3, 4 and 5 above were in conformance with the rules of the Michigan Board of Land Surveyors or by a Decree of a Court of Law; established, re-established, monumented, recovered, found as expressed below:

NOTE: Not more than 2 corners, all in the same town and range, may be recorded on this certificate.

1	A	B	C	D	E	F	G	H	I	J	K	L	M
2		6		5		4		3		2		1	
3													
4		7		8		9		10		11		12	
5													
6		18		17		16		15		14		13	
7													
8		19		20		21		22		23		24	
9													
10		30		29		28		27		26		25	
11													
12		31		32		33		34		35		36	
13													

A. Description of original monument and accessories and/or subsequent restoration:

WOOD POST SET BY J. WAMPLER, DS, IN 1821. NO EVIDENCE OF ORIGINAL CORNER REMAINS.  
 LCRC BY LEACH, L001 P573, IN 1973, NO WITNESSES REMAIN  
 LCRC BY MCGINNIS, L002 P143, IN 1974, NO WITNESSES REMAIN  
 COS BY MCGINNIS, L853 P601  
 TWO UNRECORDED COS BY RC ENGINEERING, 1986 AND 1998

B. Description of corner evidence found and/or method applied in restoring or reestablishing corner:

FOUND 3/4" IRON PIPE  
 MEASURED 2619.73' TO I-11, REC 1986 UNRECORDED COS = 2619.92', 1998 COS - 2619.90'


ACCEPTED AS THE BEST AVAILABLE EVIDENCE OF THE LOCATION OF THE ORIGINAL CORNER

C. Description of monument for corner and accessories established to perpetuate locating the position of the corner:

SET 5/8" RE-BAR W / BAY COUNTY REMON. BRASS CAP & NO. 26454 IN MONUMENT BOX  
 S45E 19.00' FCE SIGN POST  
 N50E 33.68' FCE SIGN POST  
 SOUTH 10.48' EDGE OF BIT PAVEMENT  
 N50E 135.75' SW COR HSE  
 N65E 98.95' SW COR CONC PARKING PAD

Signed by *Brian D Ferguson*  
 Surveyor's Michigan License No. 26454

Date December 15, 1999

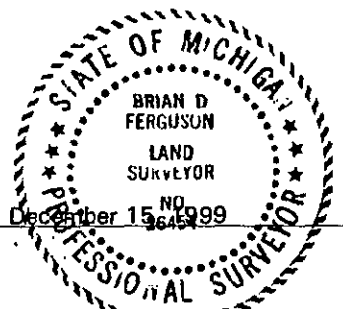

APPROVED LAND CORNER  
 P.A. 345 OF 1990 - Bay County  
 Date 8.05.99  
MM  
 Michael MacDonald P.S.  
 County Representative

004 325