

**BAY COUNTY REMONUMENTATION 1999
LAND CORNER RECORDATION CERTIFICATE
Filing Requirement of Act 74, Mich. P.A. 1970**

SECTION

For corners in

MERRITT TOWNSHIP

<u>BAY</u> (County)	Located in:	Corner Code #
1. Public Land Survey	T <u>13N</u> R <u>6E</u>	<u>J-13</u>
	T _____ R _____	_____
2. Property Controlling	S _____ T _____ R _____	_____
3. Miscellaneous	S _____ T _____ R _____	_____
Property in Sec.	S _____ T _____ R _____	_____

Brian D Ferguson
 REGISTER OF DEEDS
 BAY COUNTY, MICHIGAN

1999 DEC 29 P 12:51

RECORDED

Register of Deeds Stamp & File Number

4. Lot No. _____, Recorded Plat _____
5. Private Claims _____

I, BRIAN D FERGUSON, in a field survey on MAY, 19 99 do hereby state that under requirements of P.A. 74, Michigan P.A. of 1970, the corner points mentioned in lines 1 and 2 above were in conformance with regulations and rules therefore as required in the current manual of survey instructions of the United States Department of the Interior, Bureau of Land Management or by a decree of a Court of Law and/or that the corner points mentioned in lines 3, 4 and 5 above were in conformance with the rules of the Michigan Board of Land Surveyors or by a Decree of a Court of Law; established, re-established, monumented, recovered, found as expressed below:

NOTE: Not more than 2 corners, all in the same town and range, may be recorded on this certificate.

1	A	B	C	D	E	F	G	H	I	J	K	L	M
2		6		5		4		3		2		1	
3													
4		7		8		9		10		11		12	
5													
6		18		17		16		15		14		13	
7													
8		19		20		21		22		23		24	
9													
10		30		29		28		27		26		25	
11													
12		31		32		33		34		35		36	
13													

A. Description of original monument and accessories and/or subsequent restoration:

WOOD POST SET BY J. WAMPLER, DS, IN 1821. NO EVIDENCE OF ORIGINAL CORNER REMAINS.
NO LCRC'S OR COS'S TIED TO THIS CORNER

B. Description of corner evidence found and/or method applied in restoring or reestablishing corner:


FOUND 3/4" PIPE
LCRC SAGINAW COUNTY REMON J-1, T12N-R6E, TIES THIS CORNER IN AT 34.93' WEST
GLO CALLS FOR A DISTANCE BETWEEN CORNERS OF 34.98'

ACCEPTED AS THE BEST AVAILABLE EVIDENCE OF THE LOCATION OF THE ORIGINAL CORNER

C. Description of monument for corner and accessories established to perpetuate locating the position of the corner:

SET 5/8" RE-BAR W / BAY COUNTY REMON. BRASS CAP & NO. 26454 IN MONUMENT BOX
EAST 34.95' 3" BRASS CAP, J-1, T12N-R6E (REC 34.93' LCRC L7, P212 SAGINAW CO RECORDS
S70E 80.88' CHISLED X TOP CTR CONC DRAIN PIPE
NORTH 24.61' 5/8" REBAR 6" OFF ROAD
N50W 36.36' 5/8" REBAR 6" OFF ROAD

Signed by *Brian D Ferguson* Date December 15, 1999
Surveyor's Michigan License No. 26454

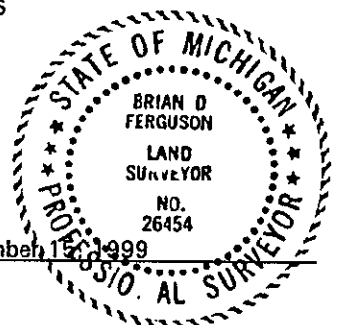

APPROVED LAND CORNER
P.A. 345 OF 1990 - Bay County
Date 11/18/99
MH
Michael MacDonald P.S.
County Representative

FORM APPROVED BY MICHIGAN STATE BOARD OF PROFESSIONAL SURVEYORS, JAN. 28, 1971
REVISED MAY 14, 1975
REVISED JAN., 1983
REVISED OCT., 1995

004 324