

SURVEY & REMONUMENTATION

MAR 31 1994

LAND CORNER RECORDATION CERTIFICATE

COMMISSIONER

FILING REQUIREMENT OF ACT 74, MICH. P.A. 1970
BAY COUNTY REMONUMENTATION PROJECT - 1993

FOR CORNERS OF--:	LOCATED IN--:	CORNER CODE NUMBER
1. PUBLIC LAND SURVEY_____	T. <u>13</u> N. S., R. <u>6</u> E. W.	<u>K-13</u>
2. PROPERTY CONTROLLING IN SECTION_____	, T. _____ N. S., R. _____ E. W.	_____
3. MISCELLANEOUS PROPERTY IN SECTION_____	, T. _____ N. S., R. _____ E. W.	_____
4. LOT NO. _____, RECORDED PLAT _____		
5. PRIVATE CLAIMS _____		

LIBER **003** PAGE **63**

REGISTER OF DEEDS
 BAY COUNTY, MICHIGAN
 JAN 27 1 45 PM '94
 RECORDED

REGISTER OF DEEDS STAMP AND FILING NUMBER


I, Duane F. Ledy, do hereby certify that under requirements of P.A. 74, Michigan P.A. of 1970, the corner points mentioned in lines 1 and 2 above were, in a field survey on DECEMBER 27, 1993, established, re-established, monumented, re-monumented, recovered or restored as expressed below and in conformance with regulations and rules therefore as required in the current manual of survey instructions of the United States Department of the Interior, Bureau of Land Management or by a decree of a court of law. Furthermore, that the corner points mentioned in lines 3, 4 and 5 above were, in a field survey on _____, 19____, found, recovered, restored, established or re-established as expressed below and in conformance with the rules of the Michigan State Board of Registration for Land Surveyors or, by a Decree of a Court of law:

A. Description of original monument and accessories and/or subsequent restoration:
 J. Wampler set post in 1821 at 80.00 chains West of M-13.

B. Description of corner evidence found and/or method applied in restoring or re-establishing corner:
 Found 1/2" rod; 1/2" rod set by C.P.Co. in May, 1972; no surveys or L.C.R.C. recorded subsequent to C.P.Co. survey. C.P.Co. survey agrees with section occupation lines; corner accepted by Bay County Peer Review Group and ratified on October 28, 1993.

C. Description of monument for corner and accessories established to perpetuate locating the position of the corner:
 Replaced 1/2" with 5/8" rod and Bay County brass cap in monument box.

East	- 24.28'	Nail & Tag in Top Wood Post on Guardrail
N 45° E	- 29.70'	Nail & Tag in End Wood Post on Guardrail
S 85° W	- 36.67'	Nail & Tag in End Wood Post on Guardrail
S 10° W	- 14.04'	Nail & Tag in Top Corner Wood Post on Guardrail

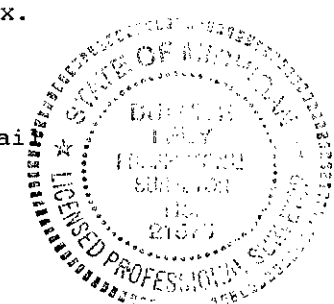

SIGNED BY Duane F. Ledy DATE January 13, 1994
 SURVEYOR'S MICHIGAN REGISTRATION NO. 21575 (SEAL)

FOR STATE AND UNITED STATES AGENCIES:
 SIGNED BY _____ DATE _____
 CHIEF OF SURVEY PARTY
 APPROVED AND SIGNED BY _____ DATE _____
 MICHIGAN REGISTERED LAND SURVEYOR (SEAL)

SURVEYOR'S MICHIGAN REGISTRATION NO. _____