

REMON. COR. A-2, WILLIAMS TWP.
 LAND CORNER RECORDATION CERTIFICATE
 Filing Requirement of Act 74, Mich. P.A. 1970

RECORDED

For corners in SECTION
 Bay

(County)	Located in:	Corner Code #
1. Public Land Survey	T <u>14N</u> R <u>3E</u>	<u>A-2</u>
	T ___ R ___	_____
	T ___ R ___	_____
	T ___ R ___	_____
2. Property Controlling in Section	S ___ T ___ R ___	_____
	S ___ T ___ R ___	_____
3. Miscellaneous Property in Sec.	S ___ T ___ R ___	_____
	S ___ T ___ R ___	_____
4. Lot No. _____, Recorded Plat _____		
5. Private Claims _____		

1999 DEC 28 P 1:01

Barbara Torres Old Person
 REGISTER OF DEEDS
 BAY COUNTY, MICHIGAN

Register of Deeds Stamp & File Number

I, **JERRY L. JONES**, in a field survey on July, 1999, do hereby certify that under requirements of P.A. 74, Michigan P.A. of 1970, the corner points mentioned on lines 1 and 2 above were in conformance with regulations and rules therefore as required in the current manual of survey instructions of the United States Department of the Interior, Bureau of Land Management or by a decree of a Court of Law and/or that the corner points mentioned in lines 3, 4 and 5 above were in conformance with the rules of the Michigan Board of Land Surveyors or by a Decree of a Court of Law; re-established, monumented, re-monumented, recovered, found as expressed below:

NOTE: Not more than 2 corners, all in the same town and range, may be recorded on this certificate.

	A	B	C	D	E	F	G	H	I	J	K	L	M
2		6	5	4	3	2	1						
3													
4		7	8	9	10	11	12						
5													
6		18	17	16	15	14	13						
7													
8		19	20	21	22	23	24						
9													
10		30	29	28	27	26	25						
11													
12		31	32	33	34	35	36						
13													

A. Description of original monument and accessories and/or subsequent restoration:


A-2 Corner common to Section 6, T14N-R3E and Section 1, T14N-R2E (M-2)

Survey by Gio, 1831, set post
 Survey by Edmands Engineering, 1972, found nail
 Survey by Ayres Associates, 1985, found 1/2" rebar

B. Description of corner evidence found and/or method applied in restoring or reestablishing corner:

A-2 1/4 Corner common to Section 6, T14N-R3E and Section 1, T14N-R2E (M-2)

Found 1/2" rod at position indicated in surveys by Edmands Engineering and Ayres Associates.

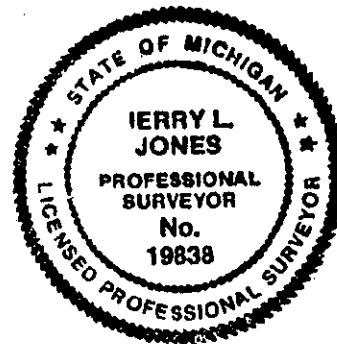

C. Description of monument for corner and accessories established to perpetuate locating the position of the corner:

A-2 1/4 Corner common to Section 6, T14N-R3E and Section 1, T14N-R2E (M-2)

Found 1/2" rod, replaced with 5/8" rod and brass cap stamped Bay County Remonumentation PS 19838 and set mon box and is accepted as the best available evidence of the position of the accepted corner.

N 20 Deg W, 117.08', nail and B.C. disc in 6" Ash.
 N 80 Deg W, 50.61', nail and B.C. disc in 4" Cherry
 N 80 Deg E, 43.7', centerline stop sign post
 S 45 Deg E, 31.40', mag nail in concrete bag howl
 On centerline Nands Road
 On centerline road to East
 10' ± South of tree line to West

Signed by Jerry L. Jones
 Surveyor's Michigan License No. 19838

Date 12/22/99

Form approved by Michigan State Board of Land Surveyors, Jan. 28, 1971
 Revised May 14, 1971
 Revised Jan., 1983

APPROVED LAND CORNER
 P.A. 345 OF 1990 - Bay County
 Date 7.20.99
HH
 Michael MacDonald P.S.
 County Representative