

**REMON. COR. A-5, WILLIAMS TWP.
LAND CORNER RECORDATION CERTIFICATE
Filing Requirement of Act 74, Mich. P.A. 1970**

RECORDED

SECTION

For corners in
Bay _____
(County)

	Located in:	Corner Code #
1. Public Land Survey	T <u>14N</u> R <u>3E</u>	<u>A-5</u>
	T _____ R _____	_____
	T _____ R _____	_____
	T _____ R _____	_____
2. Property Controlling in Section	S _____ T _____ R _____	_____
	S _____ T _____ R _____	_____
3. Miscellaneous Property in Sec.	S _____ T _____ R _____	_____
	S _____ T _____ R _____	_____
4. Lot No. _____, Recorded Plat _____		
5. Private Claims _____		

1999 DEC 28 P 1:01

Barbara Taylor DeFrees
REGISTER OF DEEDS
BAY COUNTY, MICHIGAN

Register of Deeds Stamp & File Number

I, **JERRY L. JONES**, in a field survey on July 29, 1999, do hereby certify that under requirements of P.A. 74, Michigan P.A. of 1970, the corner points mentioned on lines 1 and 2 above were in conformance with regulations and rules therefore as required in the current manual of survey instructions of the United States Department of the Interior, Bureau of Land Management or by a decree of a Court of Law and/or that the corner points mentioned in lines 3, 4 and 5 above were in conformance with the rules of the Michigan Board of Land Surveyors or by a Decree of a Court of Law; re-established, monumented, re-monumented, recovered, found as expressed below:

NOTE: Not more than 2 corners, all in the same town and range, may be recorded on this certificate.

A	B	C	D	E	F	G	H	I	J	K	L	M
2	6	5	4	3	2	1						
3												
4	7	8	9	10	11	12						
5												
6	18	17	16	15	14	13						
7												
8	19	20	21	22	23	24						
9												
10	30	29	28	27	26	25						
11												
12	31	32	33	34	35	36						
13												

A. Description of original monument and accessories and/or subsequent restoration:

A-5 Corner common to Sections 7 and 18 on West Townline

Survey by Glo, 1831, set post
Survey by J. Schafer, 1977, found 1/2" rod
LCRC by J. Schafer 1978, found 3/8" rod

B. Description of corner evidence found and/or method applied in restoring or reestablishing corner:

A-5 Corner common to Sections 7 and 18 on West Townline


Set 5/8" rod with brass cap in monument at Glo off-set 3.30 feet (5 links) N of M-5, T14N-R2E, on line with M-4 per Glo by J. Schafer and LCRC by J. Schafer, fits witnesses from 1977 and 1978 surveys.

C. Description of monument for corner and accessories established to perpetuate locating the position of the corner:

A-5 Corner common to Sections 7 and 18 on West Townline

Set 5/8" rod with brass cap stamped Bay County Remonumentation PS 19838 and set mon box and is accepted as the best available evidence of the position of the original corner.

S 40 Deg E, 41.50', nail and B.C. disc in power pole (Rec.)
S 50 Deg E, 70.02', centerline top fire hydrant
S 45 Deg W, 54.87', nail and B.C. disc in power pole (Rec.)
N 45 Deg W, 56.38', nail and B.C. disc in power pole (Rec.)
South, 3.30' M-5, T14N-R2E

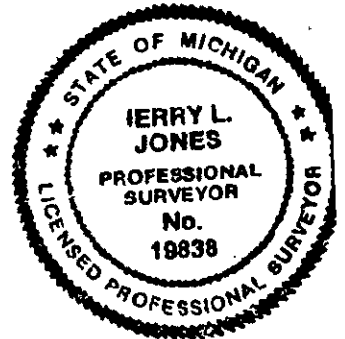

Signed by Jerry L. Jones
Surveyor's Michigan License No. 19838

Date 12/22/99
Form approved by Michigan State Board of Land Surveyors, Jan. 28, 1971
Revised May 14, 1971
Revised Jan., 1983

APPROVED LAND CORNER
P.A. 345 OF 1990 - Bay County
Date 8.05.99
MM
Michael MacDonald P.S.
County Representative