

BAY COUNTY REMONUMENTATION
LAND CORNER RECORDATION CERTIFICATE
 Filing Requirement of Act 74, Mich. P.A. 1970

For corners in

BAY
(County)

Located In: Sec. 19 Corner Code ##

- | | | |
|---------------------------------------|-------------------------|------------|
| 1. Public Land Survey | T <u>14</u> R <u>3</u> | <u>A-7</u> |
| | T <u>14</u> R <u>3</u> | <u>A-8</u> |
| | T _____ R _____ | _____ |
| | T _____ R _____ | _____ |
| 2. Property Controlling in Section | S _____ T _____ R _____ | _____ |
| | S _____ T _____ R _____ | _____ |
| 3. Miscellaneous Property in Sec. | S _____ T _____ R _____ | _____ |
| | S _____ T _____ R _____ | _____ |
| 4. Lot No. _____, Recorded Plat _____ | | |
| 5. Private Claims _____ | | |

REGISTER OF DEEDS
 BAY COUNTY, MICHIGAN
 JAN 7 2 25 PM '94
 RECORDED

Register of Deeds Stamp & File Number

I, Donald R. Burgin, in a field survey on October 30, 19 93, do hereby certify that under requirements of P.A. 74, Michigan P.A. of 1970, the corner points mentioned in lines 1 and 2 above were in conformance with regulations and rules therefore as required in the current manual of survey instructions of the United States Department of the Interior, Bureau of Land Management or by a decree of a Court of Law and/or that the corner points mentioned in lines 3, 4 and 5 above were in conformance with the rules of the Michigan Board of Land Surveyors or by a Decree of a Court of Law; established, re-established, monumented, re-monumented, recovered, found as expressed below:

A	B	C	D	E	F	G	H	I	J	K	L	M
2	6	5	4	3	2	1						
3												
4	7	8	9	10	11	12						
5												
6	18	17	16	15	14	13						
7												
8	19	20	21	22	23	24						
9												
10	30	29	28	27	26	25						
11												
12	31	32	33	34	35	36						
13												

NOTE: Not more than 4 corners, all in the same town and range, may be recorded on this certificate.

- A. Description of original monument and accessories and/or subsequent restoration:
 A-7 L.C.R.C. L.2 P.599
 A-8 L.C.R.C. L.2 P.295


SURVEY & REMONUMENTATION

MAR 3 1 1994

COMMISSION

B. Description of corner evidence found and/or method applied in restoring or reestablishing corner:

- A-7 Found 3/8" rod in Mon. Box over 3/4" pipe 1.5 ft. deep
 Removed & replaced with 5/8" rebar and Brass Cap
- A-8 Found 3/8" rod in Mon. Box
 Removed & replaced with 5/8" rebar and Brass Cap

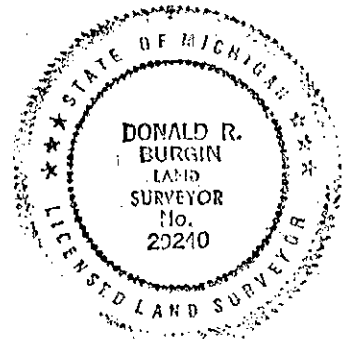

C. Description of monument for corner and accessories established to perpetuate locating the position of the corner:

A-7
 North 11.75 ft. to 1" pin in mon. box
 NE cor. Sec. 24, T14N, R2E
 (Midland County)
 N 13°E 63.47 ft. to spike in 18"
 Poplar tree
 S 78°W 95.52 ft. to 1/2" rod in headwall
 N 75°W 147.3 ft. to chiseled "X" in SE
 corner of bridge pier - 0.7' above
 ground, South face

A-8
 N 15°W 149.1 ft. to nail with Remon. tag
 in SW face of utility pole
 N 51°E 55.97 ft. to nail in NW face of
 utility pole
 S 40°E 62.22 ft. to top centerline of fire
 hydrant
 S 50°W 64.73 ft. to M.D.O.T. tag with double
 head nail in NW face of utility pole
 S 28°E 53.5 ft. to M.D.O.T. tag with double
 head nail in NW face of utility pole

Signed by Donald R. Burgin Date 12/23/93

Surveyor's Michigan License No. 29240