

BAY COUNTY REMONUMENTATION
LAND CORNER RECORDATION CERTIFICATE
Filing Requirement of Act 74, Mich. P.A. 1970

REGISTER OF DEEDS
BAY COUNTY, MICHIGAN

JAN 7 2 25 PM '94

RECORDED

For corners in

BAY	Located In:	Sec. 19	Corner Code #
(County)		Sec. 30	
1. Public Land Survey	T 14 R 3		A-9
	T 14 R 3		A-10
	T R		
	T R		
2. Property Controlling in Section	S T R		
	S T R		
3. Miscellaneous Property in Sec.	S T R		
	S T R		

Register of Deeds Stamp & File Number

- 4. Lot No. _____, Recorded Plat _____
- 5. Private Claims _____

I, Donald R. Burgin, in a field survey on October 30, 1993, do hereby certify that under requirements of P.A. 74, Michigan P.A. of 1970, the corner points mentioned in lines 1 and 2 above were in conformance with regulations and rules therefore as required in the current manual of survey instructions of the United States Department of the Interior, Bureau of Land Management or by a decree of a Court of Law and/or that the corner points mentioned in lines 3, 4 and 5 above were in conformance with the rules of the Michigan Board of Land Surveyors or by a Decree of a Court of Law; established, re-established, monumented, re-monumented, recovered, found as expressed below:

NOTE: Not more than 4 corners, all in the same town and range, may be recorded on this certificate.

- A. Description of original monument and accessories and/or subsequent restoration:
A-9 L.C.R.C. L.002 P. 512
A-10 None

SURVEY & REMONUMENTATION


MAR 3 1 1994

COMMISSION

	A	B	C	D	E	F	G	H	I	J	K	L	M
2	6		5		4		3		2		1		
3													
4	7		8		9		10		11		12		
6													
6	18		17		16		15		14		13		
7													
8	19		20		21		22		23		24		
9													
10	30		29		28		27		26		25		
11													
12	31		32		33		34		35		36		
13													

- B. Description of corner evidence found and/or method applied in restoring or reestablishing corner:
A-9 Found 3/8" rod Removed and replaced with 5/8" rebar and Brass Cap Set Monument Box

A-10 Set by single proportionate measurement between NW & SW corner of section on Township line. Set 5/8" rebar with Brass Cap and Monument Box.

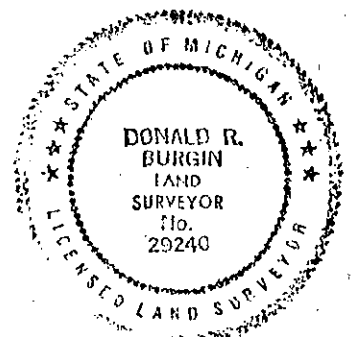

- C. Description of monument for corner and accessories established to perpetuate locating the position of the corner:

<p><u>A-9</u> N 14°W 59.3 ft. to centerline 3" steel pipe fence post, North end of fence S 40°W 62.95 ft. to chiseled "X" on top of 3" steel pipe fence post East 41.9 ft. to double head nail with M.D.O.T. reference tag in utility pole S 25°E 64.47 ft. to double head nail with M.D.O.T. reference tag in utility pole</p>	<p><u>A-10</u> N 36°W 64.25 ft. to nail & brass Remon. witness tag in SW face of utility pole N 64°E 50.1 ft. to nail in West face of utility pole, ±0.2 ft. above ground S 79°W 69.77 ft. to nail & brass remon. witness tag in SE face 16" Oak tree S 61°E 38.9 ft. to nail & brass Remon. witness tag in SW face 10" Oak tree North 12.73 ft. to East 1/4 Corner Sec. 25, T14N, R2E (Midland County)</p>
---	---

Signed by Donald R. Burgin Date 12/23/93
Surveyor's Michigan License No. 29240