

BAY COUNTY REMONUMENTATION

LAND CORNER RECORDATION CERTIFICATE
Filing Requirement of Act 74, Mich. P.A. 1970

For corners in

BAY
(County)

Located In: Sec. 19 Corner Code #

1. Public Land Survey	T	<u>14</u>	R	<u>3</u>	<u>B-7</u>
	T	<u>14</u>	R	<u>3</u>	<u>C-7</u>
	T		R		
	T		R		
2. Property Controlling in Section	S		T		
	S		T		
3. Miscellaneous Property in Sec.	S		T		
	S		T		

REGISTER OF DEEDS
 BAY COUNTY, MICHIGAN
 JAN 7 2 25 PM '94

RECORDED

Register of Deeds Stamp & File Number

4. Lot No. _____, Recorded Plat _____
 5. Private Claims _____

I, Donald R. Burgin, in a field survey on October 30, 1993, do hereby certify that under requirements of P.A. 74, Michigan P.A. of 1970, the corner points mentioned in lines 1 and 2 above were in conformance with regulations and rules therefore as required in the current manual of survey instructions of the United States Department of the Interior, Bureau of Land Management or by a decree of a Court of Law and/or that the corner points mentioned in lines 3, 4 and 5 above were in conformance with the rules of the Michigan Board of Land Surveyors or by a Decree of a Court of Law; established, re-established, monumented, re-monumented, recovered, found as expressed below:

	A	B	C	D	E	F	G	H	I	J	K	L	M
2	6		5		4		3		2		1		
3													
4	7		8		9		10		11		12		
5													
6	18		17		16		15		14		13		
7													
8	19		20		21		22		23		24		
9													
10	30		29		28		27		26		25		
11													
12	31		32		33		34		35		36		
13													

NOTE: Not more than 4 corners, all in the same town and range, may be recorded on this certificate.

A. Description of original monument and accessories and/or subsequent restoration:

- B-7 L.C.R.C. L.2 P.510
- C-7 L.C.R.C. L.2 P.449


SURVEY & REMONUMENTATION

MAR 31 1994

COMMISSIONER

B. Description of corner evidence found and/or method applied in restoring or reestablishing corner:

- B-7 Found 3/4" solid iron rod in Monument Box
Replaced with 5/8" rebar with Brass Cap.
- C-7 Found Williams & Works, Inc. "T" iron in Monument Box.
Replaced with 5/8" rebar with Brass Cap.

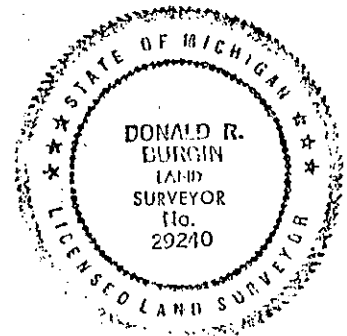

C. Description of monument for corner and accessories established to perpetuate locating the position of the corner:

- | | |
|--|---|
| <p><u>B-7</u>
 S 51°W 53.81 ft. to M.D.O.T. tag in utility pole
 N 53°W 67.38 ft. to M.D.O.T. nail and tag in guy pole
 N 29°E 30.38 ft. to top centerline of fire hydrant
 S 09°E 54.5 ft. to face of 16" twin oak tree</p> | <p><u>C-7</u>
 S 46°E 48.8 ft. to top centerline of fire hydrant
 S 58°W 39.16 ft. to M.D.O.T. tag in utility pole
 N 52°W 59.13 ft. to double head nail and disk in utility pole
 N 85°E 133 ft. to nail in utility pole</p> |
|--|---|

Signed by Donald R. Burgin Date 12/23/93

Surveyor's Michigan License No. 29240