

BAY COUNTY REMONUMENTATION
LAND CORNER RECORDATION CERTIFICATE
 Filing Requirement of Act 74, Mich. P.A. 1970

For corners in

<u>BAY</u> <small>(County)</small>	Located In: Sec. 30	Corner Code #
1. Public Land Survey	T <u>14</u> R <u>3</u>	<u>B-9</u>
	T <u>14</u> R <u>3</u>	<u>B-11</u>
	T _____ R _____	_____
	T _____ R _____	_____
2. Property Controlling in Section	S _____ T _____ R _____	_____
	S _____ T _____ R _____	_____
3. Miscellaneous Property in Sec.	S _____ T _____ R _____	_____
	S _____ T _____ R _____	_____
4. Lot No. _____, Recorded Plat _____		
5. Private Claims _____		

RECORDED
 JAN 7 2 25 PM '94
 Register of Deeds
 BAY COUNTY, MICHIGAN

Register of Deeds Stamp & File Number

I, Donald R. Burgin, in a field survey on October 30, 19 93, do hereby certify that under requirements of P.A. 74, Michigan P.A. of 1970, the corner points mentioned in lines 1 and 2 above were in conformance with regulations and rules therefore as required in the current manual of survey instructions of the United States Department of the Interior, Bureau of Land Management or by a decree of a Court of Law and/or that the corner points mentioned in lines 3, 4 and 5 above were in conformance with the rules of the Michigan Board of Land Surveyors or by a Decree of a Court of Law; established, re-established, monumented, re-monumented, recovered, found as expressed below:

NOTE: Not more than 4 corners, all in the same town and range, may be recorded on this certificate.

- A. Description of original monument and accessories and/or subsequent restoration:
- B-9 L.C.R.C. L.1 P.369
 - B-11 L.C.R.C. L.2 P.235

A	B	C	D	E	F	G	H	I	J	K	L	M
2	6	5	4	3	2	1						
3												
4	7	8	9	10	11	12						
5												
6	18	17	16	15	14	13						
7												
8	19	20	21	22	23	24						
9	●											
10	30	29	28	27	26	25						
11	●											
12	31	32	33	34	35	36						
13												


SURVEY & REMONUMENTATION

MAR 3 1 1994

COMMISSION

B. Description of corner evidence found and/or method applied in restoring or reestablishing corner:

- B-9 Found 1" iron rod
Replaced with 5/8" rebar with Brass Cap. Set Monument Box.
- B-11 Found 1" pipe in Monument Box
Set 5/8" rebar with Brass Cap over top of 1" pipe.

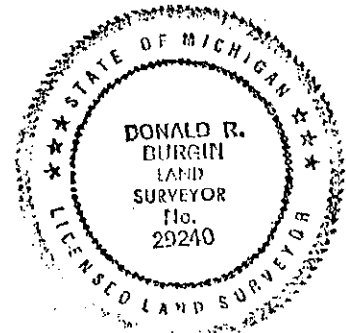

C. Description of monument for corner and accessories established to perpetuate locating the position of the corner:

- B-9
- S 43°E 106.68 ft. to NE cor. foundation House #2763
 - S 10°E 76.7 ft. to NW corner foundation House #2763
 - S 50°W 43.85 ft. to nail in East face of 12" poplar tree
 - N 02°W 23.25 ft. to nail in West face of utility pole

- B-11
- N 60°E 91.2 ft. to nail in SE face of utility pole
 - N 70°E 57.53 ft. to filed "v" in East end of 18" c.m.p.
 - N 35°E 33.1 ft. to West end 18" c.m.p. Located in Physical centerline of Salzburg Road

Signed by Donald R. Burgin Date 12/23/93
 Surveyor's Michigan License No. 29240