

BAY COUNTY REMONUMENTATION
 LAND CORNER RECORDATION CERTIFICATE
 Filing Requirement of Act 74, Mich. P.A. 1970

Register of Deeds
 BAY COUNTY, MICHIGAN

JAN 7 2 25 PM '94

RECORDED

For corners in

BAY (County) Located In: Sec. 31 Corner Code ##

- | | | |
|------------------------------------|-------------------------|------|
| 1. Public Land Survey | T <u>14</u> R <u>3</u> | A-13 |
| | T <u>14</u> R <u>3</u> | B-13 |
| | T _____ R _____ | |
| | T _____ R _____ | |
| 2. Property Controlling in Section | S _____ T _____ R _____ | |
| | S _____ T _____ R _____ | |
| 3. Miscellaneous Property in Sec. | S _____ T _____ R _____ | |
| | S _____ T _____ R _____ | |

Register of Deeds Stamp & File Number


4. Lot No. _____, Recorded Plat _____
 5. Private Claims _____

	A	B	C	D	E	F	G	H	I	J	K	L	M
2	6		5		4		3		2		1		
3													
4	7		8		9		10		11		12		
5													
6	18		17		16		15		14		13		
7													
8	19		20		21		22		23		24		
9													
10	30		29		28		27		26		25		
11													
12	31		32		33		34		35		36		
13													

I, Donald R. Burgin, in a field survey on October 30, 19 93, do hereby certify that under requirements of P.A. 74, Michigan P.A. of 1970, the corner points mentioned in lines 1 and 2 above were in conformance with regulations and rules therefore as required in the current manual of survey instructions of the United States Department of the Interior, Bureau of Land Management or by a decree of a Court of Law and/or that the corner points mentioned in lines 3, 4 and 5 above were in conformance with the rules of the Michigan Board of Land Surveyors or by a Decree of a Court of Law; established, re-established, monumented, re-monumented, recovered, found as expressed below:

NOTE: Not more than 4 corners, all in the same town and range, may be recorded on this certificate.

- A. Description of original monument and accessories and/or subsequent restoration:
- A-13 L.C.R.C. L.2 P.234
 Note: Surveys for Dow Chemical Co. show closing and standard corners reversed.
 - B-13 L.C.R.C. L.2 P.234 (Bay Co.) appears to fit 3/8" rod found 6.76 ft. West Not used.
 L.C.R.C. L.3 P.37 (Saginaw Co.)

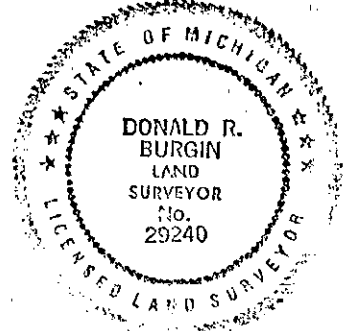

- B. Description of corner evidence found and/or method applied in restoring or reestablishing corner:
- A-13 Found 1/2" rod
 Replaced with 5/8" rebar with Brass Cap. Set Monument Box.
 - B-13 Set 5/8" rebar with Brass Cap and Monument Box by single proportionate measurement between SE and SW corners of Section on Township Line.

SURVEY & REMONUMENTATION

MAR 31 1994

COMMISSION

- C. Description of monument for corner and accessories established to perpetuate locating the position of the corner:
- | | |
|--|---|
| <u>A-13</u>
N 37°W 68.13 ft. to PK nail in SW face of utility pole
N 50°E 36.76 ft. to East end of 15" c.m.p. with filed "V"
S 25°E 61.57 ft. to spike nail in SW face of 14" Maple tree
S 06°W 46.92 ft. to face of ±5.5 ft. tall 6" steel post
South 13.2 ft. to 1/2" rerod | <u>B-13</u>
N 10°E 53.36 ft. to nail & Remon. witness tag in West face of utility pole
N 77°E 75.31 ft. to nail & Remon. witness tag in SE face of twin 16" Ash tree
S 16°E 55.16 ft. to nail & Remon. witness tag in East face of utility pole
S 55°W 73.8 ft. to centerline conc. monument with 1/2" rerod
West 6.76 ft. to 3/8" rerod |
|--|---|

Signed by Donald R. Burgin Date 12/23/93

Surveyor's Michigan License No. 29240