

BAY COUNTY REMONUMENTATION
 LAND CORNER RECORDATION CERTIFICATE
 Filing Requirement of Act 74, Mich. P.A. 1970

For corners in

BAY
 (County)

Located In: Sec. 19 Corner Code #

- | | | |
|---------------------------------------|----------|-----|
| 1. Public Land Survey | T 14 R 3 | C-8 |
| | T 14 R 3 | C-9 |
| | T R | |
| | T R | |
| 2. Property Controlling in Section | S T R | |
| | S T R | |
| 3. Miscellaneous Property in Sec. | S T R | |
| | S T R | |
| 4. Lot No. _____, Recorded Plat _____ | | |
| 5. Private Claims _____ | | |

State of Michigan
 REGISTER OF DEEDS
 BAY COUNTY, MICHIGAN

JAN 7 2 25 PM '94


RECORDED

Register of Deeds Stamp & File Number

I, Donald R. Burgin, in a field survey on October 30, 1993, do hereby certify that under requirements of P.A. 74, Michigan P.A. of 1970, the corner points mentioned in lines 1 and 2 above were in conformance with regulations and rules therefore as required in the current manual of survey instructions of the United States Department of the Interior, Bureau of Land Management or by a decree of a Court of Law and/or that the corner points mentioned in lines 3, 4 and 5 above were in conformance with the rules of the Michigan Board of Land Surveyors or by a Decree of a Court of Law; established, re-established, monumented, re-monumented, recovered, found as expressed below:

NOTE: Not more than 4 corners, all in the same town and range, may be recorded on this certificate.

- A. Description of original monument and accessories and/or subsequent restoration:
- C-8 L.C.R.C. L.2 P.295
 - C-9 L.C.R.C. L.1 P.369

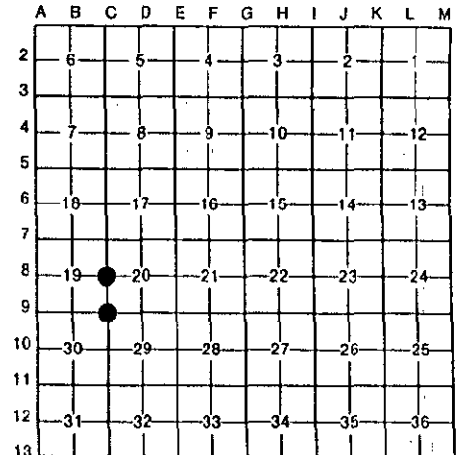


SURVEY &
 REMONUMENTATION

MAR 31 1994

B. Description of corner evidence found and/or method applied in restoring or reestablishing corner: **COMMISSION**

- C-8 Found Williams & Works, Inc. "T" iron in Monument Box. Replaced with 5/8" rebar with Brass Cap.
- C-9 Found 3/4" solid iron rod in Monument Box. Replaced with 5/8" rebar with Brass Cap.

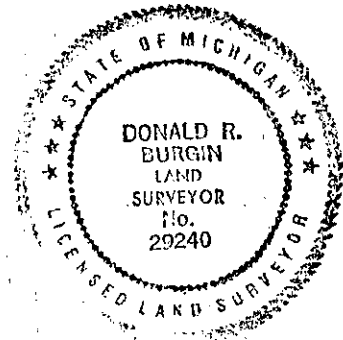

C. Description of monument for corner and accessories established to perpetuate locating the position of the corner:

- | | |
|--|--|
| <p><u>C-8</u>
 N 20°W 45.2 ft. to "v" in West end of 12" c.m.p.
 S 34°W 47.84 ft. to PK nail in SW face of utility pole
 N 40°E 60.14 ft. to PK nail in NW face of utility pole
 S 32°E 54.8 ft. to PK nail in NE face of utility pole</p> | <p><u>C-9</u>
 N 17°W 42.5 ft. to corner bridge abutment
 N 30°E 42.62 ft. to corner bridge abutment
 North 46.48 ft. to centerline of bridge expansion joint
 S 34°W 86.55 ft. to M.D.O.T. tag in SE face of utility pole</p> |
|--|--|

Signed by Donald R. Burgin

Date 12/23/93

Surveyor's Michigan License No. 29240