

BAY COUNTY REMONUMENTATION

LIBER 003 PAGE 54

LAND CORNER RECORDATION CERTIFICATE
Filing Requirement of Act 74, Mich. P.A. 1970

REGISTER OF DEEDS
 BAY COUNTY, MICHIGAN

JAN 7 2 25 PM '94

RECORDED

For corners in

BAY	Located In: Sec. 30	Corner Code #
(County)		
1. Public Land Survey	T <u>14</u> R <u>3</u>	<u>C-10</u>
	T <u>14</u> R <u>3</u>	<u>C-11</u>
	T _____ R _____	_____
	T _____ R _____	_____
2. Property Controlling in Section	S _____ T _____ R _____	_____
	S _____ T _____ R _____	_____
3. Miscellaneous Property in Sec.	S _____ T _____ R _____	_____
	S _____ T _____ R _____	_____

Register of Deeds Stamp & File Number

4. Lot No. _____, Recorded Plat _____
 5. Private Claims _____

I, Donald R. Burgin, in a field survey on October 30, 1993, do hereby certify that under requirements of P.A. 74, Michigan P.A. of 1970, the corner points mentioned in lines 1 and 2 above were in conformance with regulations and rules therefore as required in the current manual of survey instructions of the United States Department of the Interior, Bureau of Land Management or by a decree of a Court of Law and/or that the corner points mentioned in lines 3, 4 and 5 above were in conformance with the rules of the Michigan Board of Land Surveyors or by a Decree of a Court of Law; established, re-established, monumented, re-monumented, recovered, found as expressed below:

NOTE: Not more than 4 corners, all in the same town and range, may be recorded on this certificate.


A. Description of original monument and accessories and/or subsequent restoration:

- C-10 L.C.R.C. L.2 P.187
 C-11 L.C.R.C. L.2 P.235

A	B	C	D	E	F	G	H	I	J	K	L	M
2	6	5	4	3	2	1						
3												
4	7	8	9	10	11	12						
5												
6	18	17	16	15	14	13						
7												
8	19	20	21	22	23	24						
9												
10	30	29	28	27	26	25						
11												
12	31	32	33	34	35	36						
13												

B. Description of corner evidence found and/or method applied in restoring or reestablishing corner:

- C-10 Found 1" pipe
 Replaced with 5/8" rebar with Brass Cap.
 Set Monument Box.
 C-11 Found 1/2" iron rod in Monument Box.
 Replaced with 5/8" rebar with Brass Cap.

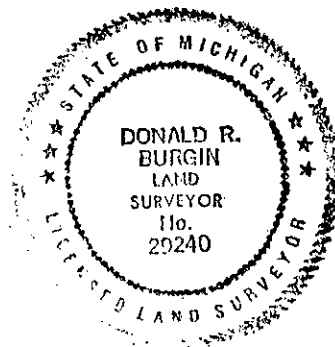

C. Description of monument for corner and accessories established to perpetuate locating the position of the corner:

- | | |
|--|--|
| <p><u>C-10</u>
 S 30°E 117.48 ft. to SW corner of foundation House #5315
 S 78°E 36.8 ft. to face of 14" pine tree
 N 72°W 36.9 ft. to face of Southerly wood gate post
 N 15°E 170.93 ft. to centerline of Southerly 3" steel gate post</p> | <p><u>C-11</u>
 N 25° W 58.83 ft. to nail with M.D.S.H. tag in West face of utility pole
 N 45°E 62.57 ft. to nail with Remon. disk in SE face of utility pole
 S 50°W 55.33 ft. to centerline of steel fiber cable warning sign post
 S 29°E 46.3 ft. to East end of 24" R.C.P. with chiseled "v"</p> |
|--|--|

Signed by Donald R. Burgin Date 12/23/93
 Surveyor's Michigan License No. 29240