

MAR 17 1999

SECTION

REMON. COR. D-11, WILLIAMS TWP.  
LAND CORNER RECORDATION CERTIFICATE  
Filing Requirement of Act 74, Mich. P.A. 1970

For corners in  
Bay

(County)

Located in:

Corner Code #

1. Public Land Survey

T 14N R 3E

D-11

T R

T R

T R

2. Property Controlling  
in Section

S T R

S T R

3. Miscellaneous  
Property in Sec.

S T R

S T R

4. Lot No. \_\_\_\_\_, Recorded Plat \_\_\_\_\_

5. Private Claims \_\_\_\_\_

1998 DEC -7 A 8:37  
REGISTER OF DEEDS  
BAY COUNTY, MICHIGAN

1998 DEC -7 A 8:37

RECORDED

Register of Deeds Stamp & File Number

I, JERRY JONES, in a field survey on July 13, 1998, do hereby certify that under requirements of P.A. 74, Michigan P.A. of 1970, the corner points mentioned on lines 1 and 2 above were in conformance with regulations and rules therefore as required in the current manual of survey instructions of the United States Department of the interior, Bureau of Land Management or by a decree of a Court of Law and/or that the corner points mentioned in lines 3, 4 and 5 above were in conformance with the rules of the Michigan Board of Land Surveyors or by a Decree of a Court of Law; re-established, monumented, re-monumented, recovered, found as expressed below:


NOTE: Not more than 2 corners, all in the same town and range, may be recorded on this certificate.

	A	B	C	D	E	F	G	H	I	J	K	L	M
2	6	5	4	3	2	1							
3													
4	7	8	9	10	11	12							
5													
6	18	17	16	15	14	13							
7													
8	19	20	21	22	23	24							
9													
10	30	29	28	27	26	25							
11													
12	31	32	33	34	35	36							
13													

A. Description of original monument and accessories and/or subsequent restoration:

D-11 Corner common to Sections 29 and 32

Survey by Glo, 1830's, set post, Harvey Parke, 1831  
Survey by MDOT 1959, (set 1" rod in mon box)  
Survey by Hunter and Whittier 1968, 1988, found 1" rod in mon box  
LCRC by E. Goss 1973, found mon box

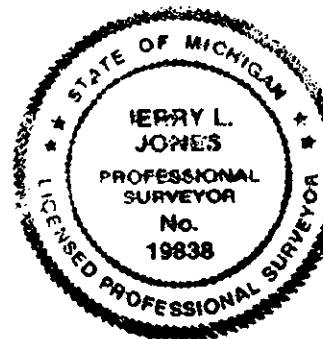

WITNESS NOTE: Witnesses from above surveys and LCRC's are available in dossier file; which was presented to peer review committee and is on file at the Register of Deeds Office.

B. Description of corner evidence found and/or method applied in restoring or reestablishing corner:

D-11 Corner common to Sections 29 and 32

Found 1" rod 30" long in mon box (dug 3' found nothing) per surveys by MDOT, Hunter and Whittier and LCRC by E. Goss

C. Description of monument for corner and accessories established to perpetuate locating the position of the corner:

D-11 Corner common to Sections 29 and 32

Found 1" rod in mon box per surveys by MDOT, Hunter and Whittier and LCRC by E. Goss; replaced rod with 5/8" rod and brass cap stamped Bay County Remonumentation PS 19838 and is accepted as the best available evidence of the position of the accepted corner.

N 55 Deg W, 23.52', southeast corner bridge curb  
S 55 Deg W, 23.82', northeast corner bridge curb  
West 20.23', expansion joint east end bridge  
S 60 Deg E, 32.43', pk nail on top guardrail post

APPROVED LAND CORNER  
P.A. 345 OF 1990 - Bay County  
Date 6 Aug 98  
MJM  
Michael MacDonald P.S.  
County Representative

Signed by Jerry L. Jones

Date 8/26/98

Surveyor's Michigan License No. 19838

Form approved by Michigan State Board of Land Surveyors, Jan. 28, 1971  
Revised May 14, 1971  
Revised Jan., 1983