

MAR 17 1999

REMON. COR. E-12, WILLIAMS TWP.
LAND CORNER RECORDATION CERTIFICATE
Filing Requirement of Act 74, Mich. P.A. 1970

SECTION
For corners in
Bay _____

(County)	Located in:	Corner Code #
1. Public Land Survey	T <u>14N</u> R <u>3E</u>	<u>E-12</u>
	T _____ R _____	_____
	T _____ R _____	_____
	T _____ R _____	_____
2. Property Controlling in Section	S _____ T _____ R _____	_____
	S _____ T _____ R _____	_____
3. Miscellaneous Property in Sec.	S _____ T _____ R _____	_____
	S _____ T _____ R _____	_____
4. Lot No. _____, Recorded Plat _____		
5. Private Claims _____		

Bay County Register of Deeds
 REGISTER OF DEEDS
 BAY COUNTY, MICHIGAN

1998 DEC - 7 A 8:37

RECORDED

Register of Deeds Stamp & File Number

	A	B	C	D	E	F	G	H	I	J	K	L	M
2	6	5	4	3	2	1							
3													
4	7	8	9	10	11	12							
5													
6	18	17	16	15	14	13							
7													
8	19	20	21	22	23	24							
9													
10	30	29	28	27	26	25							
11													
12	31	32	33	34	35	36							
13													

I, **JERRY JONES**, in a field survey on July 20, 1998, do hereby certify that under requirements of P.A. 74, Michigan P.A. of 1970, the corner points mentioned on lines 1 and 2 above were in conformance with regulations and rules therefore as required in the current manual of survey instructions of the United States Department of the Interior, Bureau of Land Management or by a decree of a Court of Law and/or that the corner points mentioned in lines 3, 4 and 5 above were in conformance with the rules of the Michigan Board of Land Surveyors or by a Decree of a Court of Law; re-established, monumented, re-monumented, recovered, found as expressed below:


NOTE: Not more than 2 corners, all in the same town and range, may be recorded on this certificate.

A. Description of original monument and accessories and/or subsequent restoration:

E-12 1/4 corner common to Sections 32 and 33

Survey by Glo, 1830's ±, set post, Harvey Parke, 1831
 Survey by Hunter and Whittier 1968, found 5/8" rod
 Survey by Edmands Engineering 1972 (set iron) 1975, 1985, found iron
 Survey by Ledy 1993, found 3/4" pipe
 LCRC by E. Goss 1973, iron

WITNESS NOTE: Witnesses from above surveys and LCRC's are available in dossier file; which was presented to peer review committee and is on file at the Register of Deeds Office.

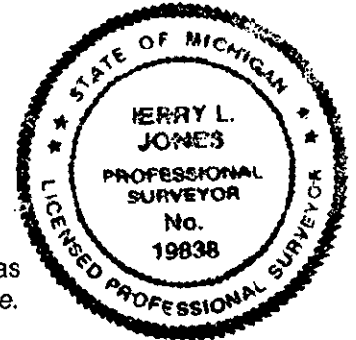

B. Description of corner evidence found and/or method applied in restoring or reestablishing corner:

E-12 1/4 corner common to Sections 32 and 33

Found 3/4" pipe 2' long ± (dug 3', found nothing) per surveys by Hunter and Whittier, Edmands Engineering, Ledy and LCRC by E. Goss

C. Description of monument for corner and accessories established to perpetuate locating the position of the corner:

E-12 1/4 corner common to Sections 32 and 33

Found 3/4" pipe per surveys by Hunter and Whittier, Edmands Engineering, Ledy and LCRC by E. Goss; replaced pipe with 5/8" rod and brass cap stamped Bay County Remonumentation PS 19838 in monument box and is accepted as the best available evidence of the position of the accepted corner.

N 50 Deg W, 33.64', mag nail in concrete bag headwall
 S 45 Deg W, 33.37', mag nail in concrete bag headwall
 N 10 Deg W, 220.62', nail and disc in power pole (R as 220.5)
 S 15 Deg W, 165.38', nail in power pole (R as 165.25)

APPROVED LAND CORNER
 P.A. 345 OF 1990 - Bay County
 Date 6 Aug 98
MMJ
 Michael MacDonald P.S.
 County Representative

Signed by Jerry L. Jones Date 8/26/98

Surveyor's Michigan License No. 19838