

MAR 17 1999

REMON. COR. E-13, WILLIAMS TWP.
LAND CORNER RECORDATION CERTIFICATE
 Filing Requirement of Act 74, Mich. P.A. 1970

SECTION

For corners in
 Bay _____
 (County)

- | | | |
|---------------------------------------|-------------------------|-------|
| 1. Public Land Survey | T 14N R 3E | E-13 |
| | T _____ R _____ | _____ |
| | T _____ R _____ | _____ |
| | T _____ R _____ | _____ |
| 2. Property Controlling in Section | S _____ T _____ R _____ | _____ |
| | S _____ T _____ R _____ | _____ |
| 3. Miscellaneous Property in Sec. | S _____ T _____ R _____ | _____ |
| | S _____ T _____ R _____ | _____ |
| 4. Lot No. _____, Recorded Plat _____ | | |
| 5. Private Claims _____ | | |

REGISTER OF DEEDS
 BAY COUNTY, MICHIGAN
 1998 DEC -7 A 8 38
 Register of Deeds Stamp & File Number
 RECORDED


I, JERRY JONES, in a field survey on July 17, 1998, do hereby certify that under requirements of P.A. 74, Michigan P.A. of 1970, the corner points mentioned on lines 1 and 2 above were in conformance with regulations and rules therefore as required in the current manual of survey instructions of the United States Department of the Interior, Bureau of Land Management or by a decree of a Court of Law and/or that the corner points mentioned in lines 3, 4 and 5 above were in conformance with the rules of the Michigan Board of Land Surveyors or by a Decree of a Court of Law; re-established, monumented, re-monumented, recovered, found as expressed below:

NOTE: Not more than 2 corners, all in the same town and range, may be recorded on this certificate.

	A	B	C	D	E	F	G	H	I	J	K	L	M
2	6	5	4	3	2	1							
3													
4	7	8	9	10	11	12							
5													
6	18	17	16	15	14	13							
7													
8	19	20	21	22	23	24							
9													
10	30	29	28	27	26	25							
11													
12	31	32	33	34	35	36							
13													

A. Description of original monument and accessories and/or subsequent restoration:

- E-13 Corner common to Sections 32 and 33 on South Townline
- Survey by Glo, Joseph Wampler, 1822, set post
 - Survey by MDOT, 1959, found
 - Survey by Hunter and Whittier 1968, found
 - Survey by Edmands Engineering 1974, 1975, found 1/2" iron
 - Survey by Ledy 1993, found 1/2" rod
 - LCRC by J. Martin 1976, 1/2" iron
 - LCRC by L. McGinnis 1977, 1/2" iron

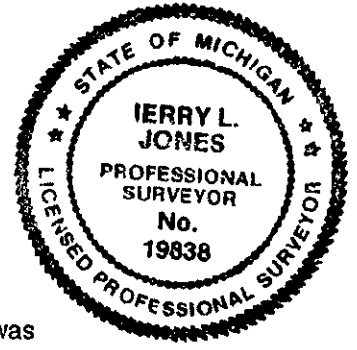

WITNESS NOTE: Witnesses from above surveys and LCRC's are available in dossier file; which was presented to peer review committee and is on file at the Register of Deeds Office.

B. Description of corner evidence found and/or method applied in restoring or reestablishing corner:

- E-13 Corner common to Sections 32 and 33 on South Townline
- Found 3/8" rod in 1" pipe 2 1/2' long in mon box (dug 3' found nothing) per surveys by MDOT, Hunter and Whittier, Edmands Engineering, Ledy and LCRC's by J. Martin and L. McGinnis

C. Description of monument for corner and accessories established to perpetuate locating the position of the corner:

- E-13 Corner common to Sections 32 and 33 on South Townline
- Found 3/8" rod in mon box per surveys by Hunter and Whittier, Edmands Engineering, Ledy and LCRC's by J. Martin and L. McGinnis; Replaced with 5/8" rod and brass cap stamped Bay County Remonumentation PS 19838 and is accepted as the best available evidence of the position of the accepted corner.
- S 15 Deg W, 40.08', nail in telephone pole stub (Rec. 39.8 Face)
 - N 20 Deg W, 122.09', nail and disc in power pole (Rec. 122.04)
 - East 44.25', pipe in mon box E-1 Saginaw County (Rec. 44.28) (T13N-R35)
 - S 5 Deg E, 97.97', nail in Elm clump
 - S 85 Deg E, 327.8', nail and BC disc in power pole
 - 1' West of centerline road to north on centerline east & west road

APPROVED LAND CORNER
 P.A. 345 OF 1990 - Bay County
 Date 24 Sept 98
MJH
 Michael MacDonald P.S.
 County Representative

Signed by Jerry L. Jones Date 12/01/98

Surveyor's Michigan License No. 19838