

SURVEY & REMONUMENTATION

MAR 17 1999

REMON. COR. G-7, WILLIAMS TWP.
LAND CORNER RECORDATION CERTIFICATE
 Filing Requirement of Act 74, Mich. P.A. 1970

For corners in
 Bay _____

(County)

SECTION

Located in:

Corner Code #

- | | | | |
|---------------------------------------|---|-------------|-------|
| 1. Public Land Survey | | T 14N R 3E | G-7 |
| | | T ___ R ___ | _____ |
| | | T ___ R ___ | _____ |
| | | T ___ R ___ | _____ |
| 2. Property Controlling in Section | S | T ___ R ___ | _____ |
| | S | T ___ R ___ | _____ |
| 3. Miscellaneous Property in Sec. | S | T ___ R ___ | _____ |
| | S | T ___ R ___ | _____ |
| 4. Lot No. _____, Recorded Plat _____ | | | |
| 5. Private Claims _____ | | | |

Barbara Teresa DeStefano
 REGISTER OF DEEDS
 BAY COUNTY, MICHIGAN

1998 DEC - 7 A 8:39

RECORDED

Register of Deeds Stamp & File Number


I, JERRY JONES, in a field survey on August 18, 1998, do hereby certify that under requirements of P.A. 74, Michigan P.A. of 1970, the corner points mentioned on lines 1 and 2 above were in conformance with regulations and rules therefore as required in the current manual of survey instructions of the United States Department of the Interior, Bureau of Land Management or by a decree of a Court of Law and/or that the corner points mentioned in lines 3, 4 and 5 above were in conformance with the rules of the Michigan Board of Land Surveyors or by a Decree of a Court of Law; re-established, monumented, re-monumented, recovered, found as expressed below:

NOTE: Not more than 2 corners, all in the same town and range, may be recorded on this certificate.

	A	B	C	D	E	F	G	H	I	J	K	L	M
2	6	5	4	3	2	1							
3													
4	7	8	9	10	11	12							
5													
6	18	17	16	15	14	13							
7													
8	19	20	21	22	23	24							
9													
10	30	29	28	27	26	25							
11													
12	31	32	33	34	35	36							
13													

A. Description of original monument and accessories and/or subsequent restoration:

- G-7 Corner common to Sections 15, 16, 21 and 22
- Survey by Glo, Harvey Parke, 1831, set post
 - Survey by Edmands Engineering 1971, 1985, 5/8" iron
 - Survey by Hunter-Whittier 1972, 1978, found
 - Survey by Ayres Associates 1980, 1986, found rod in monument box
 - Survey by Burgin 1984, 1987, found 1/2" rod in monument box
 - Survey by Ledy 1989, found 1/2" iron in box

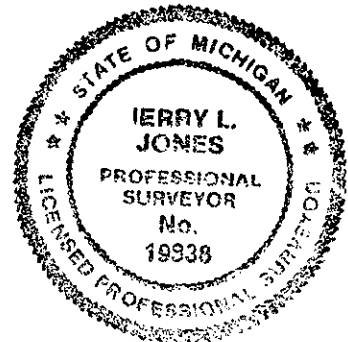

WITNESS NOTE: Witnesses from above surveys and LCRC's are available in dossier file; which was presented to peer review committee and is on file at the Register of Deeds Office.

B. Description of corner evidence found and/or method applied in restoring or reestablishing corner:

- G-7 Corner common to Sections 15, 16, 21 and 22
- Found 1/2" rod in monument box per surveys by Edmands Engineering, Hunter-Whittier, Ayres Associates, Burgin and Ledy.

C. Description of monument for corner and accessories established to perpetuate locating the position of the corner:

- G-7 Corner common to Sections 15, 16, 21 and 22
- Found 1/2" rod in monument box per surveys by Edmands Engineering, Hunter-Whittier, Ayres Associates, Burgin and Ledy. Replaced rod with 5/8" rod and brass cap, stamped Bay County Remonumentation PS 19838, and is accepted as the best available evidence of the position of the accepted corner.
- S 45 Deg E, 48.63', centerline top fire hydrant. Rec. 48.33
 - S 46 Deg E, 67.20', nail and disc in power pole. Rec. 67.19, 67.23
 - N 55 Deg E, 51.81', nail and disc in power pole. Rec. 51.45 face, 51.90
 - N 45 Deg E, 46.20', square concrete monument. Rec. 46.14, 46.3, 46.16
 - N 60 Deg W, 40.90', nail and disc in power pole. Rec. 40.80
 - S 50 Deg W, 43.90', nail and disc in power pole. Rec. 43.92

APPROVED LAND CORNER
 P.A. 345 OF 1990 - Bay County
 Date 24 Sept 98
MJN
 Michael MacDonald P.S.
 County Representative

Signed by Jerry L. Jones Date 12/01/98