

MAR 17 1999

SECTION

REMON. COR. G-10, WILLIAMS TWP. LAND CORNER RECORDATION CERTIFICATE Filing Requirement of Act 74, Mich. P.A. 1970

For corners in Bay (County)

Table with columns: Located in: Corner Code #. Rows include Public Land Survey, Property Controlling in Section, Miscellaneous Property in Sec., Lot No., and Private Claims.

Vertical stamp: REGISTER OF DEEDS BAY COUNTY, MICHIGAN

Vertical stamp: 1998 DEC -7 A 8:31

Vertical stamp: RECORDED

Register of Deeds Stamp & File Number


I, JERRY JONES, in a field survey on August 8, 1998, do hereby certify that under requirements of P.A. 74, Michigan P.A. of 1970, the corner points mentioned on lines 1 and 2 above were in conformance with regulations and rules therefore as required in the current manual of survey instructions of the United States Department of the Interior, Bureau of Land Management or by a decree of a Court of Law and/or that the corner points mentioned in lines 3, 4 and 5 above were in conformance with the rules of the Michigan Board of Land Surveyors or by a Decree of a Court of Law; re-established, monumented, re-monumented, recovered, found as expressed below:

NOTE: Not more than 2 corners, all in the same town and range, may be recorded on this certificate.

Grid table with columns A-L and rows 2-13. Contains numbers 1-36 in a grid pattern.

A. Description of original monument and accessories and/or subsequent restoration:

G-10 1/4 corner common to Sections 27 and 28 Survey by Glo, Harvey Parke, 1831, set post Survey by Ayres Associates, 1985, found 3/16" rod

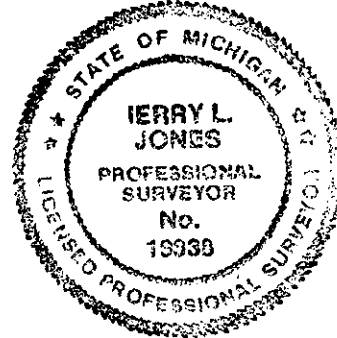

WITNESS NOTE: Witnesses from above surveys and LCRC's are available in dossier file; which was presented to peer review committee and is on file at the Register of Deeds Office.

B. Description of corner evidence found and/or method applied in restoring or reestablishing corner:

G-10 1/4 corner common to Sections 27 and 28 Found 1/2" rod in mon box per survey Ayres Associates.

C. Description of monument for corner and accessories established to perpetuate locating the position of the corner:

G-10 1/4 corner common to Sections 27 and 28 Found 1/2" rod in mon box per survey by Ayres Associates, replaced rod with 5/8" rod and brass cap stamped Bay County Remonumentation PS 19838 and is accepted as the best available evidence of the position of the accepted corner.

S 40 Deg W, 115.23', centerline water valve East, 19.95', centerline water valve, Rec. 19.70 East, 23.17', nail and BC disc in corner fence post, rec 22.83 S 30 Deg E, 55.54', nail and BC disc in 6" Pine

APPROVED LAND CORNER P.A. 345 OF 1990 - Bay County Date 21 Sept 98 M.T.M. Michael MacDonald P.S. County Representative

Signed by [Signature] Date 12/01/98

Surveyor's Michigan License No. 19838