

MAR 17 1999

REMON. COR. G-11 WILLIAMS TWP.  
LAND CORNER RECORDATION CERTIFICATE  
Filing Requirement of Act 74, Mich. P.A. 1970

SECTION

For corners in

Bay \_\_\_\_\_

(County)

Located in:

Corner Code #

1. Public Land Survey

T 14N R 3E

G-11

T \_\_\_\_\_ R \_\_\_\_\_

T \_\_\_\_\_ R \_\_\_\_\_

T \_\_\_\_\_ R \_\_\_\_\_

T \_\_\_\_\_ R \_\_\_\_\_

2. Property Controlling in Section

S \_\_\_\_\_

T \_\_\_\_\_ R \_\_\_\_\_

S \_\_\_\_\_

T \_\_\_\_\_ R \_\_\_\_\_

3. Miscellaneous

S \_\_\_\_\_

T \_\_\_\_\_ R \_\_\_\_\_

S \_\_\_\_\_

T \_\_\_\_\_ R \_\_\_\_\_

Property in Sec.

4. Lot No. \_\_\_\_\_, Recorded Plat \_\_\_\_\_

5. Private Claims \_\_\_\_\_

REGISTER OF DEEDS  
BAY COUNTY, MICHIGAN

1998 DEC -7 A 8:38

RECORDED

Register of Deeds Stamp & File Number

I, JERRY JONES, in a field survey on June 30, 1998, do hereby certify that under requirements of P.A. 74, Michigan P.A. of 1970, the corner points mentioned on lines 1 and 2 above were in conformance with regulations and rules therefore as required in the current manual of survey instructions of the United States Department of the interior, Bureau of Land Management or by a decree of a Court of Law and/or that the corner points mentioned in lines 3, 4 and 5 above were in conformance with the rules of the Michigan Board of Land Surveyors or by a Decree of a Court of Law; re-established, monumented, re-monumented, recovered, found as expressed below:

NOTE: Not more than 2 corners, all in the same town and range, may be recorded on this certificate.

	A	B	C	D	E	F	G	H	I	J	K	L	M
2	6	5	4	3	2	1							
3													
4	7	8	9	10	11	12							
5													
6	18	17	16	15	14	13							
7													
8	19	20	21	22	23	24							
9													
10	30	29	28	27	26	25							
11													
12	31	32	33	34	35	36							
13													

A. Description of original monument and accessories and/or subsequent restoration:


G-11 Corner common to Sections 27, 28, 33 and 34

Survey by Glo, Harvey Parke, 1831, set post

Survey by Edmands Engineering, 1972, 1983, 1985, 1987, 1988, 1996, found 1/2" iron

Survey by Ayres Associates, 1985, found 1/2" rod and cap

LCRC by G. Delamater, 1971, found iron

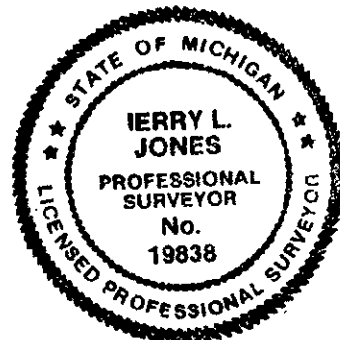

WITNESS NOTE: Witnesses from above surveys and LCRC's are available in dossier file; which was presented to peer review committee and is on file at the Register of Deeds Office.

B. Description of corner evidence found and/or method applied in restoring or reestablishing corner:

G-11 Corner common to Sections 27, 28, 33 and 34

Found 1/2" rod per surveys by Edmands Engineering, Ayres Associates, and LCRC by G. Delamater

C. Description of monument for corner and accessories established to perpetuate locating the position of the corner:

G-11 Corner common to Sections 27, 28, 33 and 34

Found 1/2" rod per surveys by Edmands Engineering, Ayres Associates, and LCRC by G. Delamater, removed rod, dug, found nothing, replaced rod with 5/8" rod and brass cap stamped Bay County Remonumentation PS 19838 in mon box, and is accepted as the best available evidence of the position of the accepted corner.

N 35 Deg E, 48.03', nail and BC disc in power pole (Rec. 47.6 Face 47.5, 47.68)

N 60 Deg E, 54.15', centerline top fire hydrant (Rec. 54.15, 54.12, 54.25)

S 45 Deg W, 40.95', nail and BC disc in power pole (Rec 40.8 Face, 41.0)

S 45 Deg E, 78.4', centerline 4" Mountain Ash

APPROVED LAND CORNER  
P.A. 345 OF 1990 - Bay County  
Date 24 Sep 98  
MJM  
Michael MacDonald P.S.  
County Representative

Signed by Jerry L. Jones

Date 12/01/98

Surveyor's Michigan License No. 19838

Form approved by Michigan State Board of Land Surveyors, Jan. 28, 1971

Revised May 14, 1971

Revised Jan., 1983