

CAR 17 1999

REMON. COR. G-13, WILLIAMS TWP.
LAND CORNER RECORDATION CERTIFICATE
Filing Requirement of Act 74, Mich. P.A. 1970

SECTION

For corners in Bay

(County)	Located in:	Corner Code #
1. Public Land Survey	T 14N R 3E	G-13
	T R	
	T R	
	T R	
2. Property Controlling In Section	S T R	
	S T R	
3. Miscellaneous Property in Sec.	S T R	
	S T R	
4. Lot No. _____, Recorded Plat		
5. Private Claims		

REGISTER OF DEEDS
 BAY COUNTY, MICHIGAN
 1998 DEC - 7 A 8:38
 Register of Deeds Stamp & File Number
 RECORDED

I, JERRY JONES, in a field survey on June 30, 1998, do hereby certify that under requirements of P.A. 74, Michigan P.A. of 1970, the corner points mentioned on lines 1 and 2 above were in conformance with regulations and rules therefore as required in the current manual of survey instructions of the United States Department of the interior, Bureau of Land Management or by a decree of a Court of Law and/or that the corner points mentioned in lines 3, 4 and 5 above were in conformance with the rules of the Michigan Board of Land Surveyors or by a Decree of a Court of Law; re-established, monumented, re-monumented, recovered, found as expressed below:


NOTE: Not more than 2 corners, all in the same town and range, may be recorded on this certificate.

	A	B	C	D	E	F	G	H	I	J	K	L	M
2	6	5	4	3	2	1							
3													
4	7	8	9	10	11	12							
5													
6	18	17	16	15	14	13							
7													
8	19	20	21	22	23	24							
9													
10	30	29	28	27	26	25							
11													
12	31	32	33	34	35	36							
13													

A. Description of original monument and accessories and/or subsequent restoration:

G-13 Corner common to Sections 33 and 34 on south Townline

Survey by Glo, Joseph Wampler, 1822, set post
 Survey by M. Hunter, 1960, found
 Survey by Wade-Trim, 1975, found 3/8" bar
 Survey by D. Burgin, 1993, found 3/8" rod
 LCRC by J. Martin, 1976, found 3/8" rod

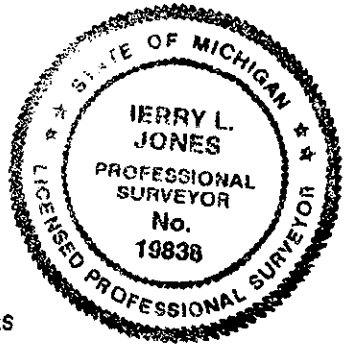

WITNESS NOTE: Witnesses from above surveys and LCRC's are available in dossier file; which was presented to peer review committee and is on file at the Register of Deeds Office.

B. Description of corner evidence found and/or method applied in restoring or reestablishing corner:

G-13 Corner common to Sections 33 and 34 on south Townline

Found 3/4" pipe in mon box at location per surveys by M. Hunter, Wade-Trim, D. Burgin, and LCRC by J. Martin.

C. Description of monument for corner and accessories established to perpetuate locating the position of the corner:

G-13 Corner common to Sections 33 and 34 on south Townline

Found 3/4" pipe in mon box (dug 3', found nothing) per surveys by M. Hunter, Wade-Trim, D. Burgin, and LCRC by J. Martin, replaced pipe with 5/8" rod and brass cap stamped Bay County Remonumentation PS 19838, and is accepted as the best available evidence of the position of the accepted corner.

S 75 Deg E, 57.41', pk nail in top guardrail post
 South, 11.06' pk nail in top guardrail post (Rec. 10.60)
 East, 39.94', 3/4" pipe in mon box (G-1 Saginaw Co.) (Rec. 39.85) (T13N-R3E)
 N 45 Deg W, 33.49', pk nail in power pole
 N 35 Deg W, 65.8', centerline 15" Maple (Rec. 65.1 Face)
 North, 6.8', centerline east and west Road (Rec. 5.6")

APPROVED LAND CORNER
 P.A. 345 OF 1990 - Bay County
 Date 24 Sept 98
M.J.N.
 Michael MacDonald P.S.
 County Representative

Signed by Jerry L. Jones Date 12/01/98

Surveyor's Michigan License No. 19838

Form approved by Michigan State Board of Land Surveyors, Jan. 28, 1971

Revised May 14, 1971

Revised Jan., 1983