

MAR 17 1999

REMON. COR. H-7, WILLIAMS TWP.  
**LAND CORNER RECORDATION CERTIFICATE**  
 Filing Requirement of Act 74, Mich. P.A. 1970

SECTION

For corners in Bay \_\_\_\_\_

(County)

Located in: Corner Code #

- |                                    |                   |       |
|------------------------------------|-------------------|-------|
| 1. Public Land Survey              | T 14N R 3E        | H-7   |
|                                    | T ___ R ___       | _____ |
|                                    | T ___ R ___       | _____ |
|                                    | T ___ R ___       | _____ |
| 2. Property Controlling in Section | S ___ T ___ R ___ | _____ |
|                                    | S ___ T ___ R ___ | _____ |
| 3. Miscellaneous Property in Sec.  | S ___ T ___ R ___ | _____ |
|                                    | S ___ T ___ R ___ | _____ |

4. Lot No. \_\_\_\_\_, Recorded Plat \_\_\_\_\_  
 5. Private Claims \_\_\_\_\_

Register of Deeds  
 BAY COUNTY, MICHIGAN

1998 DEC -1 A 8:39

RECORDED

Register of Deeds Stamp & File Number

A B C D E F G H I J K L M

2	6	5	4	3	2	1
3						
4	7	8	9	10	11	12
5						
6	18	17	16	15	14	13
7						
8	19	20	21	22	23	24
9						
10	30	29	28	27	26	25
11						
12	31	32	33	34	35	36
13						


I, JERRY JONES, in a field survey on July 14, 1998, do hereby certify that under requirements of P.A. 74, Michigan P.A. of 1970, the corner points mentioned on lines 1 and 2 above were in conformance with regulations and rules therefore as required in the current manual of survey instructions of the United States Department of the Interior, Bureau of Land Management or by a decree of a Court of Law and/or that the corner points mentioned in lines 3, 4 and 5 above were in conformance with the rules of the Michigan Board of Land Surveyors or by a Decree of a Court of Law; re-established, monumented, re-monumented, recovered, found as expressed below:

**NOTE: Not more than 2 corners, all in the same town and range, may be recorded on this certificate.**

**A. Description of original monument and accessories and/or subsequent restoration:**

H-7 1/4 Corner common to Sections 15 and 22

- Survey by Glo, Harvey Parke 1831, set post
- Hunter Eng., 1953, found rotten wood stake/several stones around it - set 3/4" pipe in center wood stake
- Survey by Edmands Engineering 1971, 1988, found 3/4" pipe
- Survey by Ayres Associates 1986, found
- Survey by Burgin 1987, found 3/4" pipe

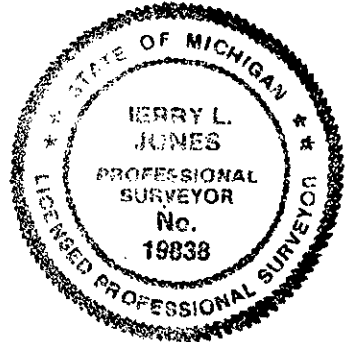

**WITNESS NOTE:** Witnesses from above surveys and LCRC's are available in dossier file; which was presented to peer review committee and is on file at the Register of Deeds Office.

**B. Description of corner evidence found and/or method applied in restoring or reestablishing corner:**

H-7 1/4 Corner common to Sections 15 and 22

- Found 3/4" pipe per surveys by Edmands Engineering, Ayres Associates, and Burgin.
- Dug to 30" found nothing more.

**C. Description of monument for corner and accessories established to perpetuate locating the position of the corner:**

H-7 1/4 Corner common to Sections 15 and 22

- Found 3/4" pipe per surveys by Edmands Engineering, Ayres Associates and Burgin. Replaced pipe with 5/8" rod and brass cap, stamped Bay Cour Remonumentation PS 19838, and monument box and is accepted as the best available evidence of the position of the accepted corner.

- N 85 Deg E, 651.81', nail and BC disc in twin 12" elm
- East 2584.18', remon section corner I-7, Rec. 2584.32, 2584.21
- West 2581.24', remon section corner G-7, Rec. 2581.04
- North 3.5', centerline paved road
- On field line to north.
- On centerline ditch to south

APPROVED LAND CORNER  
 P.A. 345 OF 1990 - Bay County  
 Date 24 Sept 98  
MJM  
 Michael MacDonald P.S.  
 County Representative

Signed by Jerry L. Jones Date 12/01/98

Surveyor's Michigan License No. 19838