

MAR 17 1999

SECTION

REMON. COR. H-13 WILLIAMS TWP.
LAND CORNER RECORDATION CERTIFICATE
Filing Requirement of Act 74, Mich. P.A. 1970

For corners in
Bay _____

(County)	Located in:	Corner Code #
1. Public Land Survey	T 14N R 3E	H-13
	T _____ R _____	_____
	T _____ R _____	_____
	T _____ R _____	_____
2. Property Controlling In Section	S _____ T _____ R _____	_____
	S _____ T _____ R _____	_____
3. Miscellaneous Property in Sec.	S _____ T _____ R _____	_____
	S _____ T _____ R _____	_____
4. Lot No. _____, Recorded Plat _____		
5. Private Claims _____		

Barbara Frances DeStavros
 REGISTER OF DEEDS
 BAY COUNTY, MICHIGAN

1998 DEC -7 A 8:38

RECORDED

Register of Deeds Stamp & File Number

I, **JERRY JONES**, in a field survey on July 28, 1998, do hereby certify that under requirements of P.A. 74, Michigan P.A. of 1970, the corner points mentioned on lines 1 and 2 above were in conformance with regulations and rules therefore as required in the current manual of survey instructions of the United States Department of the interior, Bureau of Land Management or by a decree of a Court of Law and/or that the corner points mentioned in lines 3, 4 and 5 above were in conformance with the rules of the Michigan Board of Land Surveyors or by a Decree of a Court of Law; re-established, monumented, re-monumented, recovered, found as expressed below:


NOTE: Not more than 2 corners, all in the same town and range, may be recorded on this certificate.

	A	B	C	D	E	F	G	H	I	J	K	L	M
2	6	5	4	3	2	1							
3													
4	7	8	9	10	11	12							
5													
6	18	17	16	15	14	13							
7													
8	19	20	21	22	23	24							
9													
10	30	29	28	27	26	25							
11													
12	31	32	33	34	35	36							
13													

A. Description of original monument and accessories and/or subsequent restoration:

H-13 South 1/4 corner of Section 34 on South Town Line
Survey by Glo, Joseph Wampler, 1822, set post

WITNESS NOTE: Witnesses from above surveys and LCRC's are available in dossier file; which was presented to peer review committee and is on file at the Register of Deeds Office.

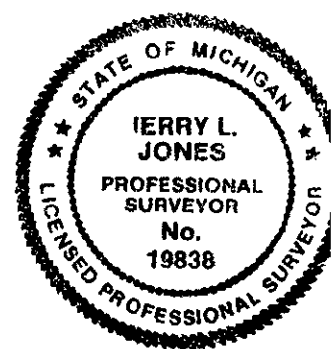

B. Description of corner evidence found and/or method applied in restoring or reestablishing corner:

H-13 South 1/4 corner of Section 34 on south Town Line
Set 5/8" rod and brass cap in monument box at midpoint between G-13 and I-13 on a straight line (Dug, found nothing)

C. Description of monument for corner and accessories established to perpetuate locating the position of the corner:

H-13 South 1/4 corner of Section 34 on South Town Line
Set 5/8" rod and brass cap stamped Bay County Remonumentation PS 19838 and is accepted as the best available evidence of the position of the accepted corner.

N 85 Deg W, 395.11', nail & BC disc in power pole
S 85 Deg W, 378.80', nail & BC disc in power pole
S 60 Deg W, 315.74', Northeast corner of house 1283
N 30 Deg E, 35.08', Northeast end CMP
North 7.0', centerline blacktop road
No Saginaw corner found.
Fits occupation (fits occupation 1/4 mile ±, North)

APPROVED LAND CORNER
P.A. 345 OF 1990 - Bay County
Date 24 Sept 98
HJM
Michael MacDonald P.S.
County Representative

Signed by Jerry L. Jones Date 12/04/98

Surveyor's Michigan License No. 19838

Form approved by Michigan State Board of Land Surveyors, Jan. 28, 1971
Revised May 14, 1971
Revised Jan., 1983