

MAR 17 1999

REMON. COR. I-8, WILLIAMS TWP.
LAND CORNER RECORDATION CERTIFICATE
 Filing Requirement of Act 74, Mich. P.A. 1970

SECTION

For corners in
Bay

(County)	Located in:	Corner Code #
1. Public Land Survey	T <u>14N</u> R <u>3E</u>	<u>I-8</u>
	T ___ R ___	_____
	T ___ R ___	_____
	T ___ R ___	_____
2. Property Controlling in Section	S ___ T ___ R ___	_____
	S ___ T ___ R ___	_____
3. Miscellaneous Property in Sec.	S ___ T ___ R ___	_____
	S ___ T ___ R ___	_____
4. Lot No. _____, Recorded Plat _____		
5. Private Claims _____		

REGISTER OF DEEDS
 BAY COUNTY, MICHIGAN
 1998 DEC -7 A 8:38
 RECORDED

Register of Deeds Stamp & File Number


I, JERRY JONES, in a field survey on July 14, 1998, do hereby certify that under requirements of P.A. 74, Michigan P.A. of 1970, the corner points mentioned on lines 1 and 2 above were in conformance with regulations and rules therefore as required in the current manual of survey instructions of the United States Department of the interior, Bureau of Land Management or by a decree of a Court of Law and/or that the corner points mentioned in lines 3, 4 and 5 above were in conformance with the rules of the Michigan Board of Land Surveyors or by a Decree of a Court of Law; re-established, monumented, re-monumented, recovered, found as expressed below:

	A	B	C	D	E	F	G	H	I	J	K	L	M
2	6	5	4	3	2	1							
3													
4	7	8	9	10	11	12							
5													
6	18	17	16	15	14	13							
7													
8	19	20	21	22	23	24							
9													
10	30	29	28	27	26	25							
11													
12	31	32	33	34	35	36							
13													

NOTE: Not more than 2 corners, all in the same town and range, may be recorded on this certificate.

A. Description of original monument and accessories and/or subsequent restoration:

- I-8 1/4 corner common to Sections 22 and 23
- Survey by Glo, 1830's ±, set post, Harvey Parke, 1831
- Survey by M. Hunter, 1956, found mon box
- Survey by Edmands Engineering, 1971, 1974, 1976, 1978, 1979, 1985, 1988, 1992
- Survey by Spicer Engineering, 1981, "T" iron in mon box
- Survey by Ayres Associates, 1983, 1995, found iron and cap in mon box
- Survey by D. Burgin, 1985, 1987, 1988, found mon box
- Survey by Wade-Trim, 1995, mon box
- LCRC by J. Juras, 1994, found "T" iron in mon box

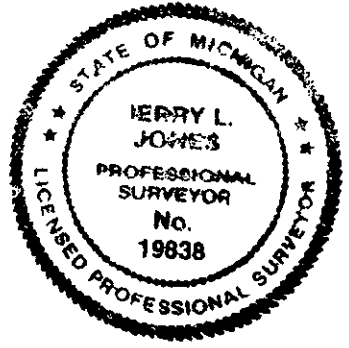

WITNESS NOTE: Witnesses from above surveys and LCRC's are available in dossier file; which was presented to peer review committee and is on file at the Register of Deeds Office.

B. Description of corner evidence found and/or method applied in restoring or reestablishing corner:

- I-8 1/4 corner common to Sections 22 and 23
- Found "T" bar in mon box (dug, found nothing) per surveys by M. Hunter, Edmands Engineering, Spicer Engineering, Ayres Associates, D. Burgin, Wade-Trim, and LCRC by J. Juras.

C. Description of monument for corner and accessories established to perpetuate locating the position of the corner:

- I-8 1/4 corner common to Sections 22 and 23
- Found "T" bar in mon box per surveys by M. Hunter, Edmands Engineering, Spicer Engineering, Ayres Associates, D. Burgin, Wade-Trim, and LCRC by J. Juras, replaced "T" bar with 5/8" rod with brass cap stamped Bay County, Remonumentation PS 19838, and is accepted as the best available evidence of the position of the accepted corner.

- N 55 Deg E, 47.96', centerline top fire hydrant (R as 48.0')
- N 12 Deg E, 120.92', centerline top fire hydrant (R as 120.92)
- N 60 Deg W, 71.34', centerline top fire hydrant (R as 71.32)
- N 53 Deg E, 56.45', pk nail in power pole
- S 25 Deg W, 75.00', northeasterly bolt on light pole base
- S 15 Deg E, 93.60', centerline top of fire hydrant

APPROVED LAND CORNER
 P.A. 345 OF 1990 - Bay County
 Date 6 Aug 98
NTM
 Michael MacDonald P.S.
 County Representative

Signed by Jerry L. Jones Date 8/26/98

Surveyor's Michigan License No. 19838

Form approved by Michigan State Board of Land Surveyors, Jan. 28, 1971
 Revised May 14, 1971
 Revised Jan., 1983