

MAR 17 1999

SECTION

REMON. COR. I-9, WILLIAMS TWP.
LAND CORNER RECORDATION CERTIFICATE
Filing Requirement of Act 74, Mich. P.A. 1970

For corners in
Bay _____
(County)

Located in: Corner Code #

- 1. Public Land Survey T 14N R 3E I-9
T _____ R _____
T _____ R _____
T _____ R _____
- 2. Property Controlling in Section S _____ T _____ R _____
S _____ T _____ R _____
- 3. Miscellaneous S _____ T _____ R _____
Property in Sec. S _____ T _____ R _____

- 4. Lot No. _____, Recorded Plat _____
- 5. Private Claims _____

REGISTER OF DEEDS
BAY COUNTY, MICHIGAN

1998 DEC -7 A 8:38

RECORDED

Register of Deeds Stamp & File Number

I, JERRY L. JONES, in a field survey on July 14, 1998, do hereby certify that under requirements of P.A. 74, Michigan P.A. of 1970, the corner points mentioned on lines 1 and 2 above were in conformance with regulations and rules therefore as required in the current manual of survey instructions of the United States Department of the interior, Bureau of Land Management or by a decree of a Court of Law and/or that the corner points mentioned in lines 3, 4 and 5 above were in conformance with the rules of the Michigan Board of Land Surveyors or by a Decree of a Court of Law; re-established, monumented, re-monumented, recovered, found as expressed below:


NOTE: Not more than 2 corners, all in the same town and range, may be recorded on this certificate.

	A	B	C	D	E	F	G	H	I	J	K	L	M
2	6	5	4	3	2	1							
3													
4	7	8	9	10	11	12							
5													
6	18	17	16	15	14	13							
7													
8	19	20	21	22	23	24							
9													
10	30	29	28	27	26	25							
11													
12	31	32	33	34	35	36							
13													

A. Description of original monument and accessories and/or subsequent restoration:

- I-9 Corner common to Sections 22, 23, 26 and 27

Survey by Glo, 1830's ±, set post, Harvey Parke, 1831
Survey by MDOT, 1958
Survey by M. Hunter, 1958, reset
Survey by Edmands Engineering, 1969, 1980, 1982
Survey by Hunter and Whittier, 1975, mon box
Survey by Ayres, 1983, 1 inch pin
Survey by Spicer Engineering, 1981, 3/4" bolt in mon box
1971-1972, LCRC by DeLamater

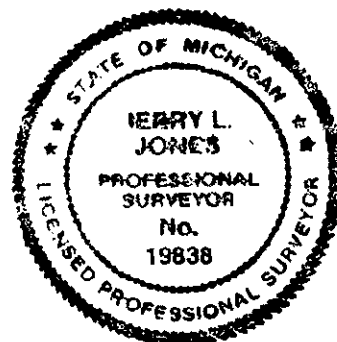

WITNESS NOTE: Witnesses from above surveys and LCRC's are available in dossier file; which was presented to peer review committee and is on file at the Register of Deeds Office.

B. Description of corner evidence found and/or method applied in restoring or reestablishing corner:

- I-9 Corner common to Sections 22, 23, 26 and 27

Found 1" rod in mon box per surveys by MDOT, M. Hunter, Edmands Engineering, Hunter and Whittier, Spicer Engineering, Ayres Associates, and LCRC by G. Delamater.

C. Description of monument for corner and accessories established to perpetuate locating the position of the corner:

- I-9 Corner common to Sections 22, 23, 26 and 27

Found 1" rod in mon box (dug, found nothing) per surveys by MDOT, M. Hunter, Edmands Engineering, Hunter and Whittier, Spicer Engineering, Ayres Associates, and LCRC by G. Delamater, replaced rod with 5/8" rod with brass cap stamped Bay County Remonumentation PS 19838, and is accepted as the best available evidence of the position of the accepted corner.

North, 106.59', exp. joint for overpass (R as 106.4')
N 45 Deg W, 29.10', mag nail in top guardrail post
S 65 Deg W, 49.34', mag nail in power pole
N 45 Deg E, 26.35', mag nail in top guardrail post
S 40 Deg E, 77.66', mag nail in power pole (R as 77.56')

APPROVED LAND CORNER
P.A. 345 OF 1990 - Bay County
Date 8 Aug 98
MJM
Michael MacDonald P.S.
County Representative

Signed by Jerry L. Jones

Date 8/26/98

Surveyor's Michigan License No. 19838

Form approved by Michigan State Board of Land Surveyors, Jan. 28, 1971

Revised May 14, 1971
Revised Jan., 1983