

MAR 7 1999

REMON. COR. I-13 WILLIAMS TWP. LAND CORNER RECORDATION CERTIFICATE Filing Requirement of Act 74, Mich. P.A. 1970

SECTION

For corners in Bay (County)

Table with columns: Located in: Corner Code #. Rows include Public Land Survey, Property Controlling in Section, Miscellaneous Property in Sec., Lot No., and Private Claims.

1998 DEC - 7 A 8:38 REGISTER OF DEEDS BAY COUNTY, MICHIGAN

Register of Deeds Stamp & File Number


Grid table with columns A-L and rows 1-13.

I, JERRY JONES, in a field survey on July 9, 1998, do hereby certify that under requirements of P.A. 74, Michigan P.A. of 1970, the corner points mentioned on lines 1 and 2 above were in conformance with regulations and rules therefore as required in the current manual of survey instructions of the United States Department of the interior, Bureau of Land Management or by a decree of a Court of Law and/or that the corner points mentioned in lines 3, 4 and 5 above were in conformance with the rules of the Michigan Board of Land Surveyors or by a Decree of a Court of Law; re-established, monumented, re-monumented, recovered, found as expressed below:

NOTE: Not more than 2 corners, all in the same town and range, may be recorded on this certificate.

A. Description of original monument and accessories and/or subsequent restoration:

I-13 Corner common to Sections 34 and 35 on South Town Line Survey by Glo, Joseph Wampler, 1822, set post Survey by Edmand Engineering 1973, set 3/8" rod, 1976 found iron Survey by Hunter and Whittier 1973, found 3/8" rod LCRC by L. McGinnis 1973, 3/8" iron LCRC by J. Schafer 1973, found 3/8" rod

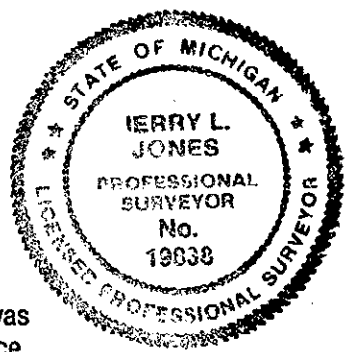

WITNESS NOTE: Witnesses from above surveys and LCRC's are available in dossier file; which was presented to peer review committee and is on file at the Register of Deeds Office.

B. Description of corner evidence found and/or method applied in restoring or reestablishing corner:

I-13 Corner common to Sections 34 and 35 on South Town Line Found 3/8" rod in monument box per surveys by Edmands Engineering, Hunter and Whittier and LCRC by L. McGinnis and J. Schafer (Dug, found nothing)

C. Description of monument for corner and accessories established to perpetuate locating the position of the corner:

I-13 Corner common to Sections 34 and 35 on South Town Line Found 3/8" rod in monument box per surveys by Edmands Engineering, Hunter and Whittier and LCRC by L. McGinnis and J. Schafer, replace rod with 5/8" rod and brass cap stamped Bay County Remonumentation PS 19838 and is accepted as the best available evidence of the position of the accepted corner N 85 Deg E, 32.60', Saginaw Co. corner (I-1, T 13N-R3E) N 30 Deg W, 40.02', nail & disc in power pole, Rec. 40.46, 39.95 face. S 05 Deg E, 30.47', Centerline C.B. S 70 Deg E, 66.42', nail and disc in power pole, Rec. 66.86 S 45 Deg W, 23.61', chiseled "+" in west end large CMP

APPROVED LAND CORNER P.A. 345 OF 1990 - Bay County Date 24 Sept 98 MJM Michael MacDonald P.S. County Representative

Signed by Jerry L. Jones Date 12/01/98

Surveyor's Michigan License No. 19838

Form approved by Michigan State Board of Land Surveyors, Jan. 28, 1971

Revised May 14, 1971 Revised Jan., 1983