

SURVEY & REMONUMENTATION

APR 23 1998

BAY COUNTY REMONUMENTATION

LAND CORNER RECORDATION CERTIFICATE
Filing Requirement of Act 74, Mich. P.A. 1970

SECTION

For corners in

BAY Located in: WILLIAMS TWP Corner Code #
(County)

1. Public Land Survey	T <u>14N</u> R <u>3E</u>	<u>K-5</u>
	T _____ R _____	_____
2. Property Controlling in Section	S _____ T _____ R _____	_____
	S _____ T _____ R _____	_____
3. Miscellaneous Property in Sec.	S _____ T _____ R _____	_____
	S _____ T _____ R _____	_____


REGISTER OF DEEDS
 BAY COUNTY, MICHIGAN
 DEC 30 3 51 PM '97
 RECORDED

Register of Deeds Stamp & File Number

4. Lot No. _____ Recorded Plat _____
 5. Private Claims _____

I, BRIAN D FERGUSON, in a field survey on MAY 5, 19 97, do hereby state that under requirements of P.A. 74, Michigan P.A. of 1970, the corner points mentioned in lines 1 and 2 above were in conformance with regulations and rules therefore as required in the current manual of survey instructions of the United States Department of the Interior, Bureau of Land Management or by a decree of a Court of Law and/or that the corner points mentioned in lines 3, 4 and 5 above were in conformance with the rules of the Michigan Board of Land Surveyors or by a Decree of a Court of Law; established, re-established, monumented, recovered, found as expressed below:

NOTE: Not more than 2 corners, all in the same town and range, may be recorded on this certificate.

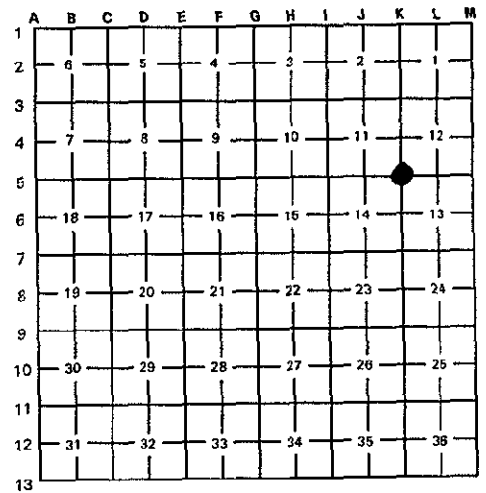

A. Description of original monument and accessories and/or subsequent restoration:

K-5 WOOD POST SET BY JOHN MULLETT IN 1830 - 31
 NO EVIDENCE OF ORIGINAL CORNER REMAINS
 NO LCRC'S RECORDED FOR THIS CORNER

B. Description of corner evidence found and/or method applied in restoring or reestablishing corner:

K-5 FOUND 3/8" IRON ROD W/3/4" PIPE BELOW
 POSITION AGREES WITH LOCATION PER SURVEYS RECORDED IN L 733 P 322; L 962 P 417

THIS POSITION IS ACCEPTED AS THE BEST AVAILABLE EVIDENCE OF THE POSITION OF THE ORIGINAL CORNER

C. Description of monument for corner and accessories established to perpetuate locating the position of the corner:

- K-5 SET 5/8" ROD W/3" BRASS BAY COUNTY REMONUMENTATION CAP IN MONUMENT BOX
- | | | |
|------|--------|----------------------------|
| S45E | 59.75' | SPIKE IN W. FCE PWR POLE |
| N45W | 66.55' | NAIL & TAG IN PWR POLE |
| N45E | 55.60' | NAIL IN NW FCE OF 18" TREE |
| S50W | 27.15' | TOP CTR OF 72" C.M.P. |



Signed by Brian D Ferguson Date NOVEMBER 19, 1997
 Surveyor's Michigan License No. 26454

APPROVED LAND CORNER
 P.A. 345 OF 1990 - Bay County
 Date 27 June 97
MJM
 Michael MacDonald P.S.