

**SURVEY & REMONUMENTATION**

**APR 23 1998**

**REMON COR. K-7, WILLIAMS TWP  
LAND CORNER RECORDATION CERTIFICATE  
Filing Requirement of Act 74, Mich. P.A. 1970**

**SECTION**

For corners in  
Bay  
(County)

Located in: Corner Code #  
T 14N R 3E K-7  
T R  
T R  
T R  
S T R  
S T R  
S T R  
S T R

REGISTER OF DEEDS  
 BAY COUNTY, MICHIGAN  
 Nov 10 7 30 AM '97  
 RECORDED

Register of Deeds Stamp & File Number

- 1. Public Land Survey
- 2. Property Controlling In Section
- 3. Miscellaneous Property in Sec.

- 4. Lot No. \_\_\_\_\_, Recorded Plat \_\_\_\_\_
- 5. Private Claims \_\_\_\_\_


I, **JERRY L. JONES**, in a field survey on July 15, 1997, do hereby certify that under requirements of P.A. 74, Michigan P.A. of 1970, the corner points mentioned on lines 1 and 2 above were in conformance with regulations and rules therefore as required in the current manual of survey instructions of the United States Department of the interior, Bureau of Land Management or by a decree of a Court of Law and/or that the corner points mentioned in lines 3, 4 and 5 above were in conformance with the rules of the Michigan Board of Land Surveyors or by a Decree of a Court of Law; re-established, monumented, re-monumented, recovered, found as expressed below:

**NOTE: Not more than 2 corners, all in the same town and range, may be recorded on this certificate.**

	A	B	C	D	E	F	G	H	I	J	K	L	M
2	6	5	4	3	2	1							
3													
4	7	8	9	10	11	12							
5													
6	18	17	16	15	14	13							
7													
8	19	20	21	22	23	24							
9													
10	30	29	28	27	26	25							
11													
12	31	32	33	34	35	36							
13													

**A. Description of original monument and accessories and/or subsequent restoration:**

K-7 Corner common to Sections 13, 14, 23 and 24  
 Government survey, set post, 1839, John Mullett  
 Survey by J. Schafer, 1971, found iron with 3/8" rod in center, L-673, P-578  
 Survey by P. Ciosek, 1984, found railroad spike, L-962, P-725  
 LCRC by L. McGinnis, 1977, found 3/8" iron, L-002, P-41

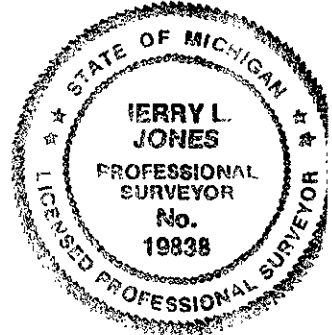

**WITNESS NOTE:** Witnesses from above surveys and LCRC's are available in dossier file; which was presented to peer review committee and is on file at the Register of Deeds Office.

**B. Description of corner evidence found and/or method applied in restoring or reestablishing corner:**

K-7 Corner common to Sections 13, 14, 23 and 24  
 Found railroad spike in monument box per surveys by J. Schafer, P. Ciosek and LCRC by L. McGinnis.

**C. Description of monument for corner and accessories established to perpetuate locating the position of the corner:**

K-7 Corner common to Sections 13, 14, 23 and 24  
 Found railroad spike in monument box, replaced spike with 5/8" rod and brass cap stamped Bay County Remonumentation PS 19838, per surveys by J. Schafer, P. Ciosek and LCRC by L. McGinnis and is accepted as the best available evidence of the position of the accepted corner.  
 S 60 Deg E, 81.10', NW corner garage (R)  
 S 55 Deg E, 42.27', nail in power pole  
 N 80 Deg E, 43.19', nail and Bay County disc in power pole  
 N 50 Deg E, 76.35', SW corner block building  
 N 50 Deg W, 43.35', pk nail in power pole (R)  
 corner is in center line of roads

APPROVED LAND CORNER  
 P.A. 345 OF 1990 - Bay County  
 Date 27 June 97  
HJM  
 Michael MacDonald P.S.  
 County Representative

Signed by Jerry L. Jones Date 10/22/97

Surveyor's Michigan License No. 19838