

SURVEY & REMONUMENTATION

APR 23 1998

REMON COR. K-8, WILLIAMS TWP
LAND CORNER RECORDATION CERTIFICATE
 Filing Requirement of Act 74, Mich. P.A. 1970

SECTION
 For corners in
 Bay _____
 (County)

- | | | |
|---------------------------------------|---------------------------|------------|
| 1. Public Land Survey | T <u>14</u> N R <u>3E</u> | <u>K-8</u> |
| | T _____ R _____ | _____ |
| | T _____ R _____ | _____ |
| | T _____ R _____ | _____ |
| 2. Property Controlling in Section | S _____ T _____ R _____ | _____ |
| | S _____ T _____ R _____ | _____ |
| 3. Miscellaneous Property in Sec. | S _____ T _____ R _____ | _____ |
| | S _____ T _____ R _____ | _____ |
| 4. Lot No. _____, Recorded Plat _____ | | |
| 5. Private Claims _____ | | |

Register of Deeds
 BAY COUNTY, MICHIGAN

Nov 10 7 30 AM '97

RECORDED

Register of Deeds Stamp & File Number


I, JERRY L. JONES, in a field survey on July 15, 1997, do hereby certify that under requirements of P.A. 74, Michigan P.A. of 1970, the corner points mentioned on lines 1 and 2 above were in conformance with regulations and rules therefore as required in the current manual of survey instructions of the United States Department of the Interior, Bureau of Land Management or by a decree of a Court of Law and/or that the corner points mentioned in lines 3, 4 and 5 above were in conformance with the rules of the Michigan Board of Land Surveyors or by a Decree of a Court of Law; re-established, monumented, re-monumented, recovered, found as expressed below:

NOTE: Not more than 2 corners, all in the same town and range, may be recorded on this certificate.

	A	B	C	D	E	F	G	H	I	J	K	L	M
2	6	5	4	3	2	1							
3													
4	7	8	9	10	11	12							
5													
6	18	17	16	15	14	13							
7													
8	19	20	21	22	23	24							
9													
10	30	29	28	27	26	25							
11													
12	31	32	33	34	35	36							
13													

A. Description of original monument and accessories and/or subsequent restoration:

- K-8 1/4 corner common to Sections 23 and 24
- Government survey, 1830's, set post
 Survey by Edmands Engineering, 1976, 1984, 1991, found mon box, L-798, P-600, L-799, P-628
 Survey by Hunter-Whittier, 1979, found 1" shaft in mon box, L-873, P-193
 LCRC by J. McMahon, found handhole, L-002, P-221
 LCRC by L. McGinnis, found 3/4" rod in mon box, L-003, P-08

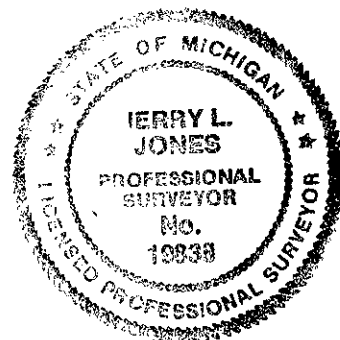

WITNESS NOTE: Witnesses from above surveys and LCRC's are available in dossier file; which was presented to peer review committee and is on file at the Register of Deeds Office.

B. Description of corner evidence found and/or method applied in restoring or reestablishing corner:

- K-8 1/4 corner common to Sections 23 and 24
- Found 3/4" rod iron in mon box per surveys by Edmands Engineering, Hunter-Whittier and LCRC by J. McMahon and L. McGinnis

C. Description of monument for corner and accessories established to perpetuate locating the position of the corner:

- K-8 1/4 corner common to Sections 23 and 24
- Found 3/4" rod in mon box per surveys by Edmands Engineering, Hunter-Whittier and LCRC by J. McMahon and L. McGinnis, replaced iron with 5/8" rod and brass cap stamped, Bay County Remonumentation PS 19838, and is accepted as the best available evidence of the position of the accepted corner.
- S 50 Deg W, 59.37', nail and Bay Co. disc in power pole, (R)
 S 45 Deg E, 41.51, nail and Bay Co. disc in power pole (R)
 S 50 Deg E, 16.3', centerline manhole (R)
 N 60 Deg E, 58.70', nail and Bay Co. disc in power pole
 N 35 Deg E, 59.56', centerline hydrant
 N 45 Deg W, 50.10', SE corner brick building (R)

APPROVED LAND CORNER
 P.A. 345 OF 1990 - Bay County
 Date 10/22/97
MTM
 Michael MacDonald P.S.
 County Representative

Signed by Jerry L. Jones Date 10/22/97

Surveyor's Michigan License No. 19838

