

SURVEY & REMONUMENTATION

APR 23 1998

BAY COUNTY REMONUMENTATION

SECTION

LAND CORNER RECORDATION CERTIFICATE
Filing Requirement of Act 74, Mich. P.A. 1970

For corners in

BAY Located in: WILLIAMS TWP Corner Code #
(County)

1. Public Land Survey T 14N R 3E L-5
T _____ R _____

2. Property Controlling S _____ T _____ R _____
in Section S _____ T _____ R _____

3. Miscellaneous S _____ T _____ R _____
Property in Sec. S _____ T _____ R _____

REGISTER OF DEEDS
BAY COUNTY, MICHIGAN

Dec 30 3 51 PM '97

RECORDED

Register of Deeds Stamp & File Number

4. Lot No. _____, Recorded Plat _____
5. Private Claims _____

I, BRIAN D FERGUSON, in a field survey on MAY 5, 19 97 do hereby state that under requirements of P.A. 74, Michigan P.A. of 1970, the corner points mentioned in lines 1 and 2 above were in conformance with regulations and rules therefore as required in the current manual of survey instructions of the United States Department of the Interior, Bureau of Land Management or by a decree of a Court of Law and/or that the corner points mentioned in lines 3, 4 and 5 above were in conformance with the rules of the Michigan Board of Land Surveyors or by a Decree of a Court of Law; established, re-established, monumented, recovered, found as expressed below:

NOTE: Not more than 2 corners, all in the same town and range, may be recorded on this certificate.

1	A	B	C	D	E	F	G	H	I	J	K	L	M
2		6		5		4		3		2		1	
3													
4		7		8		9		10		11		12	
5												●	
6		18		17		16		15		14		13	
7													
8		19		20		21		22		23		24	
9													
10		30		29		28		27		26		25	
11													
12		31		32		33		34		35		36	
13													

A. Description of original monument and accessories and/or subsequent restoration:

L-5 WOOD POST SET BY JOHN MULLETT IN 1830 - 31
NO EVIDENCE OF ORIGINAL CORNER REMAINS
NO LCRC'S RECORDED FOR THIS CORNER

B. Description of corner evidence found and/or method applied in restoring or reestablishing corner:


L-5 FOUND 3/8" IRON ROD
POSITION AGREES WITH RECORDED SURVEYS IN L 907 P 291; L 733 P 322; L 962 P 417

THIS POSITION IS ACCEPTED AS THE BEST AVAILABLE EVIDENCE OF THE POSITION OF THE ORIGINAL CORNER

C. Description of monument for corner and accessories established to perpetuate locating the position of the corner:

L-5 SET 5/8" ROD W/3" BRASS BAY COUNTY REMONUMENTATION DISK IN MONUMENT BOX

S25W	51.06'	N FCE PETROLEUM PIPE LINE MARKER
S30W	32.60'	NAIL IN N FCE PWR POLE
N40E	58.80'	SW FCE 30" MAPLE TREE
N30W	34.52'	E FCE TWIN 8" ASH TREE

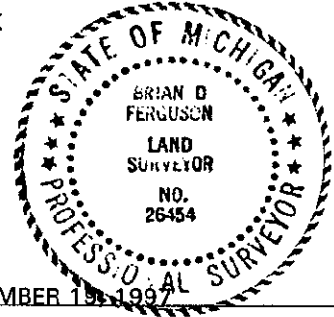

Signed by Brian D Ferguson Date NOVEMBER 19 1997
Surveyor's Michigan License No. 26454

APPROVED LAND CORNER
P.A. 345 OF 1990 - Bay County
Date 21 July 97
MJM
Michael MacDonald P.S.
County Representative