

**SURVEY & REMONUMENTATION**

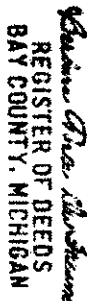
APR 23 1998

REMON COR. L-9, WILLIAMS TWP  
**LAND CORNER RECORDATION CERTIFICATE**  
 Filing Requirement of Act 74, Mich. P.A. 1970

**SECTION**

For corners in Bay \_\_\_\_\_

(County)	Located in:	Corner Code #
1. Public Land Survey	T <u>14N</u> R <u>3E</u>	<u>L-9</u>
	T _____ R _____	_____
	T _____ R _____	_____
	T _____ R _____	_____
2. Property Controlling in Section	S _____ T _____ R _____	_____
	S _____ T _____ R _____	_____
3. Miscellaneous Property in Sec.	S _____ T _____ R _____	_____
	S _____ T _____ R _____	_____
4. Lot No. _____, Recorded Plat _____		
5. Private Claims _____		

  
 REGISTER OF DEEDS  
 BAY COUNTY, MICHIGAN

Nov 10 7 30 AM '97  
 RECORDED

Register of Deeds Stamp & File Number

I, JERRY L. JONES, in a field survey on July 21, 1997, do hereby certify that under requirements of P.A. 74, Michigan P.A. of 1970, the corner points mentioned on lines 1 and 2 above were in conformance with regulations and rules therefore as required in the current manual of survey instructions of the United States Department of the interior, Bureau of Land Management or by a decree of a Court of Law and/or that the corner points mentioned in lines 3, 4 and 5 above were in conformance with the rules of the Michigan Board of Land Surveyors or by a Decree of a Court of Law; re-established, monumented, re-monumented, recovered, found as expressed below:

**NOTE: Not more than 2 corners, all in the same town and range, may be recorded on this certificate.**

	A	B	C	D	E	F	G	H	I	J	K	L	M
2	6	5	4	3	2	1							
3													
4	7	8	9	10	11	12							
5													
6	18	17	16	15	14	13							
7													
8	19	20	21	22	23	24							
9													
10	30	29	28	27	26	25							
11													
12	31	32	33	34	35	36							
13													

**A. Description of original monument and accessories and/or subsequent restoration:**

L-9 1/4 corner common to Sections 24 and 25  
 Government survey, 1830's, set post

WITNESS NOTE: Witnesses from above surveys and LCRC's are available in dossier file; which was presented to peer review committee and is on file at the Register of Deeds Office.



**B. Description of corner evidence found and/or method applied in restoring or reestablishing corner:**

L-9 1/4 corner common to Sections 24 and 25  
 Found 1/2" rod  
 Spicer Engineering verified verbally on June 3, 1997 that this is the corner they are using.

L-9 1/4 corner common to Sections 24 and 25  
 Found 1/2" rod, replaced rod with 5/8" rod and brass cap stamped, Bay County Remonumentation PS 19838, and is accepted as the best available evidence of the position of the accepted corner.

- N 5 Deg W, 63.87', chiseled "+" in concrete hdwl
- N 40 Deg E, 26.75', nail and Bay County disc in fence post
- N 40 Deg W, 25.13', nail and Bay County disc in fence post
- N 60 Deg W, 59.00', nail and Bay County disc in fence post
- West, 6', center line N & S ditch
- North, 19', expressway right of way fence

APPROVED LAND CORNER  
 P.A. 345 OF 1990 - Bay County  
 Date 11 Sept 97  
MTM  
 Michael MacDonald P.S.  
 County Representative

Signed by Jerry L. Jones Date 10/01/97  
 Surveyor's Michigan License No. 19838

Form approved by Michigan State Board of Land Surveyors, Jan. 28, 1971  
 Revised May 14, 1971  
 Revised Jan., 1983