

**SURVEY &
REMONUMENTATION**

APR 23 1998

BAY COUNTY REMONUMENTATION

LAND CORNER RECORDATION CERTIFICATE
Filing Requirement of Act 74, Mich. P.A. 1970

SECTION

For corners in

<u>BAY</u> (County)	Located in:	Corner Code #
1. Public Land Survey	T <u>14N</u> R <u>3E</u>	<u>M-5</u>
	T <u>14N</u> R <u>4E</u>	<u>A-5</u>
2. Property Controlling in Section	S <u> </u> T <u> </u> R <u> </u>	_____
	S <u> </u> T <u> </u> R <u> </u>	_____
3. Miscellaneous Property in Sec.	S <u> </u> T <u> </u> R <u> </u>	_____
	S <u> </u> T <u> </u> R <u> </u>	_____

Dec 30 3 51 PM '97
 REGISTER OF DEEDS
 BAY COUNTY, MICHIGAN

RECORDED

Register of Deeds Stamp & File Number

4. Lot No. _____, Recorded Plat _____
 5. Private Claims _____

I, BRIAN D. FERGUSON, in a field survey on MAY 5, 19 97 do hereby state that under requirements of P.A. 74, Michigan P.A. of 1970, the corner points mentioned in lines 1 and 2 above were in conformance with regulations and rules therefore as required in the current manual of survey instructions of the United States Department of the Interior, Bureau of Land Management or by a decree of a Court of Law and/or that the corner points mentioned in lines 3, 4 and 5 above were in conformance with the rules of the Michigan Board of Land Surveyors or by a Decree of a Court of Law; established, re-established, monumented, recovered, found as expressed below:

NOTE: Not more than 2 corners, all in the same town and range, may be recorded on this certificate.

1	A	B	C	D	E	F	G	H	I	J	K	L	M
2		6		5		4		3		2			
3													
4		7		8		9		10		11		12	
5													
6		18		17		16		15		14		13	
7													
8		19		20		21		22		23		24	
9													
10		30		29		28		27		26		25	
11													
12		31		32		33		34		35		36	
13													

A. Description of original monument and accessories and/or subsequent restoration:

M-5 & A-5 WOOD POST SET BY JOHN MULLETT IN 1830 - 31
 NO EVIDENCE OF ORIGINAL CORNER REMAINS
 NO LCRC'S RECORDED FOR THIS CORNER
 ORIGINAL SURVEY ESTABLISHED THIS CORNER AS A COMMON CORNER IN BOTH
 RANGE 3 EAST AND RANGE 4 EAST


B. Description of corner evidence found and/or method applied in restoring or reestablishing corner:

M-5 & A-5 FOUND 3/8" ROD REFERED TO BY SURVEY RECORDED IN L 907 P 291
 AGREES WITH WITNESSES AND DISTANCES NORTH AND WEST

THIS POSITION IS ACCEPTED AS THE BEST AVAILABLE EVIDENCE OF THE POSITION OF THE ORIGINAL CORNER

C. Description of monument for corner and accessories established to perpetuate locating the position of the corner:

M-5 & A-5 SET 5/8" ROD W/3" BRASS BAY COUNTY REMONUMENTATION DISK IN MONUMENT BOX
 S70E 57.54' TOP CTR AMERITECH RISER
 N20E 48.44' R.R. SPIKE IN NW FCE PWR POLE
 S05W 31.24' CTR OF 8" GAS PIPELINE MARKER
 N50W 67.70' PK NAIL IN S FCE PWR POLE

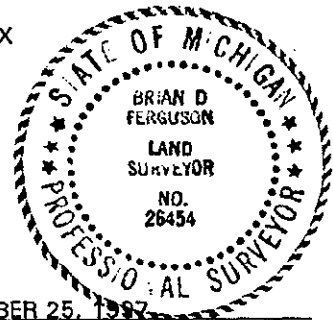

Signed by Brian D. Ferguson Date NOVEMBER 25, 1997
 Surveyor's Michigan License No. 26454

APPROVED LAND CORNER
 P.A. 345 OF 1990 - Bay County
 Date 31 July 97
MTM
 Michael MacDonald P.S.
 County Registrar

FORM APPROVED BY MICHIGAN STATE BOARD OF PROFESSIONAL SURVEYORS, JAN. 28, 1971
 REVISED MAY 14, 1975
 REVISED JAN., 1983
 REVISED OCT., 1995