

SURVEY & REMONUMENTATION

APR 23 1998

REMON COR. M-9, WILLIAMS TWP LAND CORNER RECORDATION CERTIFICATE Filing Requirement of Act 74, Mich. P.A. 1970

For corners SECTION
Bay
(County)

Located in:	Corner Code #	
1. Public Land Survey	T 14N R 3E	M-9
	T 14N R 4E	A-9
	T ___ R ___	
	T ___ R ___	
2. Property Controlling in Section	S ___ T ___ R ___	
	S ___ T ___ R ___	
3. Miscellaneous Property in Sec.	S ___ T ___ R ___	
	S ___ T ___ R ___	

REGISTER OF DEEDS
 BAY COUNTY, MICHIGAN
 Nov 10 7 30 AM '97

RECORDED

Register of Deeds Stamp & File Number

4. Lot No. _____, Recorded Plat _____
5. Private Claims _____

I, JERRY L. JONES, in a field survey on July 15, 1997, do hereby certify that under requirements of P.A. 74, Michigan P.A. of 1970, the corner points mentioned on lines 1 and 2 above were in conformance with regulations and rules therefore as required in the current manual of survey instructions of the United States Department of the Interior, Bureau of Land Management or by a decree of a Court of Law and/or that the corner points mentioned in lines 3, 4 and 5 above were in conformance with the rules of the Michigan Board of Land Surveyors or by a Decree of a Court of Law; re-established, monumented, re-monumented, recovered, found as expressed below:

	A	B	C	D	E	F	G	H	I	J	K	L	M
2	6	5	4	3	2	1							
3													
4	7	8	9	10	11	12							
5													
6	18	17	16	15	14	13							
7													
8	19	20	21	22	23	24							
9													
10	30	29	28	27	26	25							
11													
12	31	32	33	34	35	36							
13													


NOTE: Not more than 2 corners, all in the same town and range, may be recorded on this certificate.

A. Description of original monument and accessories and/or subsequent restoration:

M-9/~~A-9~~ Corner common to Sections 24, 25 T14N-R3E and 19, 30 T14N-R4E

Government survey, set post, 1822, J. Wampler
Survey by Edmands Engineering, 1971, 1976, found 3/8" rerod, L-664, P-195 and L-795, P-~~649~~
Survey by Burgin Land Surveys, 1990, found 3/8" iron rod, L-1220, P-43

WITNESS NOTE: Witnesses from above surveys and LCRC's are available in dossier file; which was presented to peer review committee and is on file at the Register of Deeds Office.

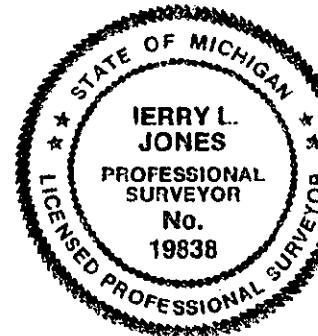

B. Description of corner evidence found and/or method applied in restoring or reestablishing corner:

M-9/~~A-9~~ Corner common to Sections 24, 25 T14N-R3E and 19, 30 T14N-R4E

Found 3/8" rerod on top of 1" pipe per surveys by Edmands Engineering and Burgin Land Surveys

C. Description of monument for corner and accessories established to perpetuate locating the position of the corner:

M-9/~~A-9~~ Corner common to Sections 24, 25 T14N-R3E and 19, 30 T14N-R4E

Found 3/8" rerod per surveys by Edmands Engineering and Burgin Land Surveys, replaced rerod with 5/8" rerod and brass cap stamped, Bay County Remonumentation PS 19838 in mon box, and is accepted as the best available evidence of the position of the accepted corner.

N 60 Deg E, 20.03', nail and Bay County disc in guard rail post (R)
N 45 Deg W, 12.23', nail and Bay County disc in guard rail post (R)
N 40 Deg E, 31.96', nail and Bay County disc in fence post
N 52 Deg E, 21.52', pk nail in top of old guard rail post (R)
N 62 Deg W, 62.41', pk nail in telephone pole (R)

APPROVED LAND CORNER
P.A. 345 OF 1990 - Bay County
Date 27 June 97
MJM
Michael MacDonald P.S.
County Representative

Signed by Jerry L. Jones Date 10/22/97

Surveyor's Michigan License No. 19838

Form approved by Michigan State Board of Land Surveyors, Jan. 28, 1971
Revised May 14, 1971
Revised Jan., 1983