

**SURVEY &  
REMONUMENTATION**

APR 26 1995

**BAY COUNTY REMONUMENTATION**

**COMMISSION**

**LAND CORNER RECORDATION CERTIFICATE  
Filing Requirement of Act 74, Mich. P.A. 1970**

For corners in

Bay

(County)

Located In:

Corner Code ##

- |                                    |         |                      |            |
|------------------------------------|---------|----------------------|------------|
| 1. Public Land Survey              |         | <u>T14 N. R 4 E.</u> | <u>K-2</u> |
|                                    |         | T _____ R _____      | _____      |
|                                    |         | T _____ R _____      | _____      |
|                                    |         | T _____ R _____      | _____      |
| 2. Property Controlling in Section | S _____ | T _____ R _____      | _____      |
|                                    | S _____ | T _____ R _____      | _____      |
| 3. Miscellaneous Property in Sec.  | S _____ | T _____ R _____      | _____      |
|                                    | S _____ | T _____ R _____      | _____      |

4. Lot No. \_\_\_\_\_, Recorded Plat \_\_\_\_\_  
5. Private Claims \_\_\_\_\_

Michigan State Board of Land Surveyors  
 REGISTER OF DEEDS  
 BAY COUNTY, MICHIGAN

DEC 9 9 55 AM '94

RECORDED

**003 135**

Register of Deeds Stamp & File Number

I, Ronald C. Prevost, in a field survey on June 13, 1994, do hereby certify that under requirements of P.A. 74, Michigan P.A. of 1970, the corner points mentioned in lines 1 and 2 above were in conformance with regulations and rules therefore as required in the current manual of survey instructions of the United States Department of the Interior, Bureau of Land Management or by a decree of a Court of Law and/or that the corner points mentioned in lines 3, 4 and 5 above were in conformance with the rules of the Michigan Board of Land Surveyors or by a Decree of a Court of Law; established, re-established, monumented, re-monumented, recovered, found as expressed below:

**NOTE: Not more than 4 corners, all in the same town and range, may be recorded on this certificate.**

	A	B	C	D	E	F	G	H	I	J	K	L	M
2	6		5		4		3		2		1		
3													
4	7		8		9		10		11		12		
5													
6	13		17		16		15		14		13		
7													
8	19		20		21		22		23		24		
9													
10	30		29		28		27		26		25		
11													
12	31		32		33		34		35		36		
13													

A. Description of original monument and accessories and/or subsequent restoration:

K-2 No Post set in Original Survey  
Quarter Section corner in river

3. Description of corner evidence found and/or method applied in restoring or reestablishing corner:


K-2 Location determined to be in river, location determined by single proportion between K-1 & K-3  
 K-1 to K-3 = 5,277.85  
 K-1 to K-2 = 2,642.21  
 K-2 to K-3 = 2,635.63

APPROVED LAND CORNER  
 P.A. 345 OF 1990 - Bay County  
 Date 25 Aug 94  
MN  
 Michael MacDonald P.S.  
 County Representative

2. Description of monument for corner and accessories established to perpetuate locating the position of the corner:

K-2 Place witness corner on Section line K-1, K-3 92.00' S of true location. 5/8" rod, 2 3/4" Bay Co. Brass Cap (Stamped W.C. 92.00) in concrete filled 3" x 30" pipe in Mon. Box

Nail & Bay Co. tag E Face P Pole N.75°E. 10.69  
 S to corner K-3 2,543.63  
 N to corner K-1 2,734.21  
 3' S of S bank of Kawkawlin River

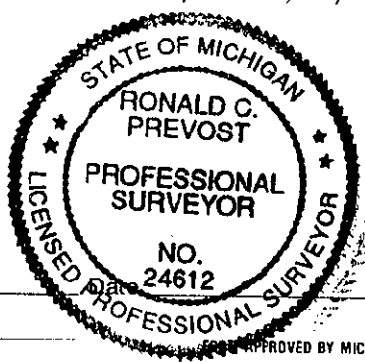

Signed by Ronald C. Prevost  
 Surveyor's Michigan License No. 24612

11-30-94