

**SURVEY &
REMONUMENTATION**

BAY COUNTY REMONUMENTATION

APR 26 1995

LAND CORNER RECORDATION CERTIFICATE
Filing Requirement of Act 74, Mich. P.A. 1970

COMMISSION

For corners in

Bay

(County)

Located In:

Corner Code //

- | | | |
|------------------------------------|-------------------------|-------|
| 1. Public Land Survey | T 14 N. R 4 E. | K-5 |
| | T _____ R _____ | _____ |
| | T _____ R _____ | _____ |
| | T _____ R _____ | _____ |
| 2. Property Controlling in Section | S _____ T _____ R _____ | _____ |
| | S _____ T _____ R _____ | _____ |
| 3. Miscellaneous Property in Sec. | S _____ T _____ R _____ | _____ |
| | S _____ T _____ R _____ | _____ |

4. Lot No. _____, Recorded Plat _____
5. Private Claims _____

Register of Deeds
 BAY COUNTY, MICHIGAN

DEC 9 9 56 AM '94


RECORDED

003 138

Register of Deeds Stamp & File Number

I, Ronald C. Prevost, in a field survey on June 14, 19 94, do hereby certify that under requirements of P.A. 74, Michigan P.A. of 1970, the corner points mentioned in lines 1 and 2 above were in conformance with regulations and rules therefore as required in the current manual of survey instructions of the United States Department of the Interior, Bureau of Land Management or by a decree of a Court of Law and/or that the corner points mentioned in lines 3, 4 and 5 above were in conformance with the rules of the Michigan Board of Land Surveyors or by a Decree of a Court of Law; established, re-established, monumented, re-monumented, recovered, found as expressed below:

NOTE: Not more than 4 corners, all in the same town and range, may be recorded on this certificate.

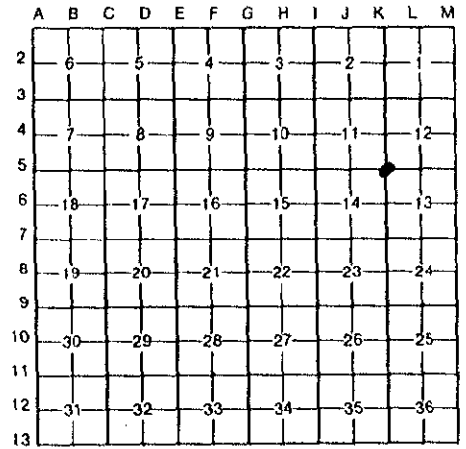

A. Description of original monument and accessories and/or subsequent restoration:

- K-5 Post Set by John Mullett 1839
 Beech 10" N.24°E. 20 Lks.
 Beech 9" N.85°W. 24 Lks.
 LCRC, L.1, P.97, Mon. McGinnis 1972
 LCRC, L.2, P.598, 3/8" Rod Mon. Box, Hughes 1989
 Recorded Surveys - L.1007, P.522, Mon. Box, McGinnis 1985


3. Description of corner evidence found and/or method applied in restoring or reestablishing corner:

- K-5 Found 1/4" Rod in Mon Box & Recorded Witnesses as follows:
 N.31°E. 56.95 To Top Nut of W Leg Tower (56.90 M)
 S.02°E. 90.20 To Top Nut of W Leg Tower (90.07 M)
 S.29°W. 62.50 To Pole Nail SE Face (62.38 M)

APPROVED LAND CORNER
 P.A. 345 OF 1990 - Bay County
 Date 7 Aug 94
MM
 Michael MacDonald P.S.
 County Representative

D. Description of monument for corner and accessories established to perpetuate locating the position of the corner:

- K-5 Placed 5/8" Rerod & 2 3/4" Bay Co. Brass Cap in existing Mon. Box in location of 1/4" Rod
 Center Hydrant N.40°W. 65.36
 S Leg High-Tension Tower N.45°E. 50.17
 Nail in E Face P Pole S.45°E. 76.05
 Nail in E Face P Pole S.30°W. 62.38

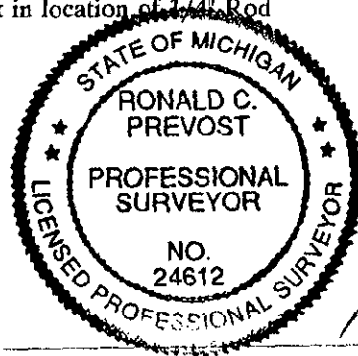

Signed by Ronald C. Prevost

Date

11-30-94

Surveyor's Michigan License No. 24612