

SURVEY & REMONUMENTATION

APR 26 1995

COMMISSION

BAY COUNTY REMONUMENTATION

LAND CORNER RECORDATION CERTIFICATE

Filing Requirement of Act 74, Mich. P.A. 1970

REGISTER OF DEEDS
 BAY COUNTY MICHIGAN

DEC 7 11 17 AM '94

RECORDED

For corners in
Bay

| | | |
|---------------------------------------|------------------------------|----------------|
| (County) | Located In: | Corner Code // |
| 1. Public Land Survey | T <u>14 N.</u> R <u>4 E.</u> | <u>L-1</u> |
| | T _____ R _____ | _____ |
| | T _____ R _____ | _____ |
| | T _____ R _____ | _____ |
| 2. Property Controlling in Section | S _____ T _____ R _____ | _____ |
| | S _____ T _____ R _____ | _____ |
| 3. Miscellaneous Property in Sec. | S _____ T _____ R _____ | _____ |
| | S _____ T _____ R _____ | _____ |
| 4. Lot No. _____, Recorded Plat _____ | | |
| 5. Private Claims _____ | | |

003 129

Register of Deeds Stamp & File Number

| | | | | | | | | | | | | | |
|----|----|----|----|----|----|----|---|---|---|---|---|---|---|
| | A | B | C | D | E | F | G | H | I | J | K | L | M |
| 2 | 6 | 5 | 4 | 3 | 2 | 1 | | | | | | | |
| 3 | | | | | | | | | | | | | |
| 4 | 7 | 8 | 9 | 10 | 11 | 12 | | | | | | | |
| 5 | | | | | | | | | | | | | |
| 6 | 18 | 17 | 16 | 15 | 14 | 13 | | | | | | | |
| 7 | | | | | | | | | | | | | |
| 8 | 19 | 20 | 21 | 22 | 23 | 24 | | | | | | | |
| 9 | | | | | | | | | | | | | |
| 10 | 30 | 29 | 28 | 27 | 26 | 25 | | | | | | | |
| 11 | | | | | | | | | | | | | |
| 12 | 31 | 32 | 33 | 34 | 35 | 36 | | | | | | | |
| 13 | | | | | | | | | | | | | |

I, Ronald C. Prevost, in a field survey on June 6, ~~November 4~~, 1994

do hereby certify that under requirements of P.A. 74, Michigan P.A. of 1970, the corner points mentioned in lines 1 and 2 above were in conformance with regulations and rules therefore as required in the current manual of survey instructions of the United States Department of the Interior, Bureau of Land Management or by a decree of a Court of Law and/or that the corner points mentioned in lines 3, 4 and 5 above were in conformance with the rules of the Michigan Board of Land Surveyors or by a Decree of a Court of Law; established, re-established, monumented, re-monumented, recovered, found as expressed below:

NOTE: Not more than 4 corners, all in the same town and range, may be recorded on this certificate.

A. Description of original monument and accessories and/or subsequent restoration:

L-1 Post Set by John Mullett 1839 (S 1/4 Post, Sec. 36, T.15 N.-R.4 E.)
 Should be common corner with T.15 N.-R.4 E.
 W. Oak 18" N.75°E. 14 Lks.
 B. Oak 6" S.04°W. 79 Lks.
 Recorded surveys L.695, P.83, no witness, L.737, P.105, no witness, L.1135, P.868, no witness, L.701, P.269, no witness, L.1075, P.488 has witness.
 Corner L-1 is common with L-13, T.15 N.-R.4 E.


B. Description of corner evidence found and/or method applied in restoring or reestablishing corner:

L-1 Found 1/2" Rod w/cap #27695 T. Lapham
 Found Rec'd Witnesses from L.1075, P.488
 S.02°W. 21.0 Face U Pole
 S.02°E. 138.5 NW cor. brick church
 Found witnesses from Ledy unrecorded survey #100.2274, 1993
 S 21.6 (21.61 M) Spike in P Pole
 NE 15.70 (15.60 M) Spike in 14" Maple
 NW 23.10 (22.98 M) Spike in 24" Maple (Oak)
 SW 11.65 (11.80 M) Spike in 16" Maple (Oak)

C. Description of monument for corner and accessories established to perpetuate locating the position of the corner:

L-1 Placed 3" x 30" Steel Pipe with 5/8" Re-bar in center, 2 3/4" Bay Co. Brass Cap on Re-bar all in concrete and in Mon. Box in place of 1/2" rod. NOTE: Found 3/4" pipe under 1/2" rod while excavating for Mon. Box.
 Nail & Ribbon W Face P Pole S.02°W. 21.61
 Nail & Ribbon S Face 18" Maple N.85°E. 15.60
 Nail & Ribbon E Face 30" Oak N.20°W. 22.98
 Nail & Ribbon S Face 24" Oak S.85°W. 11.80

APPROVED LAND CORNER
 P.A. 345 OF 1990 - Bay County
 Date 25 Aug 94
MM
 Michael MacDonald P.S.
 County Representative

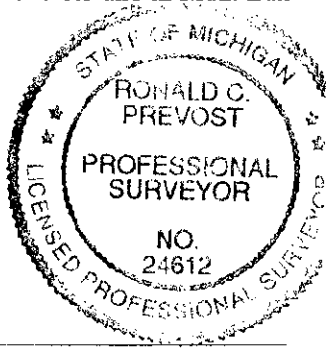

signed by Ronald C. Prevost
 Surveyor's Michigan License No. 24612

Date 11-11-94