

**SURVEY &
REMONUMENTATION**

APR 26 1995

BAY COUNTY REMONUMENTATION

COMMISSION

**LAND CORNER RECORDATION CERTIFICATE
Filing Requirement of Act 74, Mich. P.A. 1970**

For corners in
Bay
(County)

Located In:

Corner Code :#

1. Public Land Survey	T	14 N.	R	4 E.	L-7
	T		R		
	T		R		
	T		R		
2. Property Controlling in Section	S		T	R	
	S		T	R	
3. Miscellaneous Property in Sec.	S		T	R	
	S		T	R	

003

144

Register of Deeds Stamp & File Number

Michigan State Board of Land Surveyors
 REGISTER OF DEEDS
 BAY COUNTY RECORDS

DEC 9 9 56 AM '94

RECORDED

1. Lot No. _____, Recorded Plat _____
 2. Private Claims _____

Ronald C. Prevost, in a field survey on June 11, 1994,
 to hereby certify that under requirements of P.A. 74, Michigan P.A. of 1970, the corner points mentioned
 in lines 1 and 2 above were in conformance with regulations and rules therefore as required in the
 current manual of survey instructions of the United States Department of the Interior, Bureau of Land
 Management or by a decree of a Court of Law and/or that the corner points mentioned in lines 3, 4 and 5
 above were in conformance with the rules of the Michigan Board of Land Surveyors or by a Decree of a
 Court of Law; established, re-established, monumented, re-monumented, recovered, found as
 expressed below:

**NOTE: Not more than 4 corners, all in the same town and range, may be recorded
 on this certificate.**

	A	B	C	D	E	F	G	H	I	J	K	L	M
2	6		5		4		3		2				
3													
4	7		8		9		10		11		12		
5													
6	18		17		16		15		14		13		
7													
8	19		20		21		22		23		24		
9													
10	30		29		28		27		26		25		
11													
12	31		32		33		34		35		36		
13													

1. Description of original monument and accessories and/or subsequent restoration:

L-7 Post Set by John Mullett 1839
 Beech 8" N. 5°E. 14 Lks.
 Beech 12" S.80°E. 47 Lks.
 LCRC - L.2, P.600 3/4" Pipe, Hughes 1989
 Recorded Surveys L.866, P.952, L.798, P.605, L.727, P.143, L.874, P.740, L.745, P.510, L.812, P.242

2. Description of corner evidence found and/or method applied in restoring or reestablishing corner:

L-7 Found 3/4" Pipe From LCRC witnesses
 N.30°W. 33.70 4" X 4" M.B.T. Post (33.68 M)


APPROVED LAND CORNER
 P.A. 345 OF 1990 - Bay County
 Date 17 July 94
MM
 Michael MacDonald P.S.
 County Representative

3. Description of monument for corner and accessories established to perpetuate locating the position of the corner:

L-7 Placed Mon. Box, 5/8" Rebar with 2 3/4" Bay Co. Brass Cap in place of 3/4" Pipe
 Found old small Mon. Box directly below and about 10" down
 Nail W Face Cable Marker Post N.10°E. 33.68
 Nail & Washer N Face 6" Poplar N.50°W. 58.99
 Nail & Washer N Face 36" Oak S.15°E. 36.02
 0.7' S of bituminous centerline

Signed by Ronald C. Prevost

Surveyor's Michigan License No. 24612

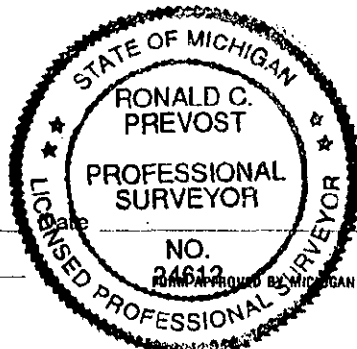

11-30-94