

SURVEY & REMONUMENTATION

APR 26 1995

Bay County Remonumentation

COMMISSION

LAND CORNER RECORDATION CERTIFICATE
Filing Requirement of Act 74, Mich. P.A. 1970

For corners in
Bay

(County)

Located In:

Corner Code 11

- | | | |
|---------------------------------------|------------------------------|------------|
| 1. Public Land Survey | T <u>14 N.</u> R <u>4 E.</u> | <u>M-1</u> |
| | T _____ R _____ | _____ |
| | T _____ R _____ | _____ |
| | T _____ R _____ | _____ |
| 2. Property Controlling in Section | S _____ T _____ R _____ | _____ |
| | S _____ T _____ R _____ | _____ |
| 3. Miscellaneous Property in Sec. | S _____ T _____ R _____ | _____ |
| | S _____ T _____ R _____ | _____ |
| 4. Lot No. _____, Recorded Plat _____ | | |
| 5. Private Claims _____ | | |

REGISTER OF DEEDS
 BAY COUNTY, MICHIGAN

DEC 7 11 17 AM '94

RECORDED

003 130

Register of Deeds Stamp & File Number

	A	B	C	D	E	F	G	H	I	J	K	L	M
2	6	5	4	3	2	1							
3													
4	7	8	9	10	11	12							
5													
6	18	17	16	15	14	13							
7													
8	19	20	21	22	23	24							
9													
10	30	29	28	27	26	25							
11													
12	31	32	33	34	35	36							
13													

Ronald C. Prevost in a field survey on June 6 ~~November 4~~, 1994

do hereby certify that under requirements of P.A. 74, Michigan P.A. of 1970, the corner points mentioned in lines 1 and 2 above were in conformance with regulations and rules therefore as required in the current manual of survey instructions of the United States Department of the Interior, Bureau of Land Management or by a decree of a Court of Law and/or that the corner points mentioned in lines 3, 4 and 5 above were in conformance with the rules of the Michigan Board of Land Surveyors or by a Decree of a Court of Law; established, re-established, monumented, re-monumented, recovered, found as expressed below:

NOTE: Not more than 4 corners, all in the same town and range, may be recorded on this certificate.

A. Description of original monument and accessories and/or subsequent restoration:

- M-1 Post Set by John Mullett
 W. Pine 14" S.09°E. 18 Lks.
 W. Pine 30" N.75°W 56 Lks.
 LCRC, L.1, P.259 & L.1, P.41
 L.2, P.601 Hughes 1989
 Recorded survey Edmands Eng. L.866, P.536
 Corner M-1 is common with A-1, T.14 N.-R.5 E.


3. Description of corner evidence found and/or method applied in restoring or reestablishing corner:

- M-1 Found 1/2" Rod & Recorded Witnesses as follows:
 N.50°E. 40.25 (40.29 M) Top Fire Hyd.
 N.40°W. 42.30 (42.08 M) T Pole w/nail

2. Description of monument for corner and accessories established to perpetuate locating the position of the corner:

- M-1 Replaced 1/2" Rod with 5/8" Re-Bar w/2 3/4" Bay Co. Brass Cap, Placed Mon. Box
 Nail & Cap W. Face P & T Pole S.01°E. 32.76
 P.K. Nail SW Face T Pole N.45°W. 42.08
 SW Cor. Blk Fndn House N.40°E. 68.21
 Center Hydrant N.60°E. 40.29

APPROVED LAND CORNER
 P.A. 345 OF 1990 - Bay County
 Date 23 June 94
MM
 Michael MacDonald P.S.
 County Representative

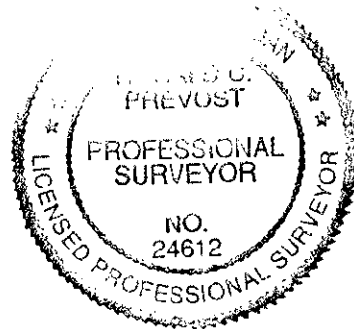

Signed by Ronald C. Prevost
 24612

Date 11-11-94

Surveyor's Michigan License No. _____