SURVEY &
REMONUMENTATION

APR 2 6 1995

COMMISSION

BAY COUNTY REMONUMENTATION

LAND CORNER RECORDATION CERTIFICATE
Filing Requirement of Act 74, Mich. P.A. 1970

For corners in
Bay
(County)

	Located In:	Corner Code //
1. Public Land Survey	T 14 N. R 4 E.	M-5
	T ____ R ____	
	T ____ R ____	
	T ____ R ____	
2. Property Controlling	S ____ T ____ R ____	
in Section	S ____ T ____ R ____	
3. Miscellaneous	S T R	
Property in Sec.	S ____ T ____ R ____	

Register of Deeds
REGISTER OF DEEDS
BAY COUNTY, MICHIGAN

DEC 7 11 15 AM '94

RECORDED

003 126

Register of Deeds Stamp & File Number

4. Lot No. _____, Recorded Plat _____
5. Private Claims _____

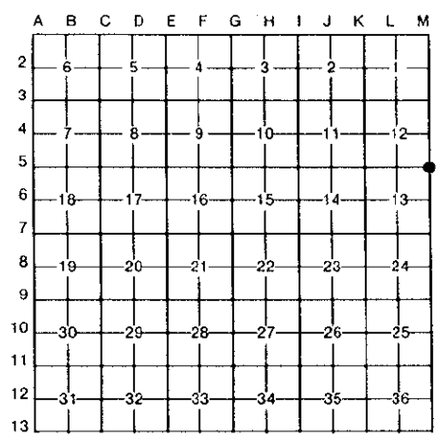

I, Ronald C. Prevost, in a field survey on ~~November 4~~ June 7, 19 94 do hereby certify that under requirements of P.A. 74, Michigan P.A. of 1970, the corner points mentioned in lines 1 and 2 above were in conformance with regulations and rules therefore as required in the current manual of survey instructions of the United States Department of the Interior, Bureau of Land Management or by a decree of a Court of Law and/or that the corner points mentioned in lines 3, 4 and 5 above were in conformance with the rules of the Michigan Board of Land Surveyors or by a Decree of a Court of Law; established, re-established, monumented, re-monumented, recovered, found as expressed below:

NOTE: Not more than 4 corners, all in the same town and range, may be recorded on this certificate.

A. Description of original monument and accessories and/or subsequent restoration:

M-5 Post Set by John Mullett 1839.
Beech 6" N 28 W 22 Lks.
Beech 10" S 2 W 34 Lks
LCRC, L.2, P.602 3/8" Rod, Hughes 1989
LCRC, L.3, P.76 3/8" Rod/Mon. Box, Juras 1994
Recorded surveys L.1007, P.522, L.881, P.135, L.737, P.573, L.1014, P.411, L.1014, P.434, L.834, P.486, L.861, P.450, L.1006, P.734
Corner M-5 is common with A-5, T.14 N.-R.5 E.

B. Description of corner evidence found and/or method applied in restoring or reestablishing corner:

M-5 Round 1/2" Rod in Mon. Box per LCRC's
Found Rec'd Witnesses:
N.55°E. 61.80 (61.93 M) to P.P. w/nail W. side
S.45°W. 59.18 (60.59 M) to P.P. w/nail W. side
S.50°E. 66.00 (65.90 M) to P.P. w/nail E. side
N.45°W. 58.90 (58.75 M) to P.P. w/P.K. S. side

C. Description of monument for corner and accessories established to perpetuate locating the position of the corner:

M-5 Placed 5/8" Rod & 2 3/4" Bay Co. Brass Cap in existing Mon. Box
Nail & Washer in N. Face P. Pole N.55°E. 61.93
Nail & Washer in E. Face P. Pole S.45°W. 60.59
Nail & Washer in N. Face P. Pole S.50°E. 65.90
Nail & Washer in S. Face P. Pole N.45°W. 58.75

APPROVED LAND CORNER
P.A. 345 OF 1990 - Bay County
Date 23 June 94
MM
Michael MacDonald P.S.
County Representative

STATE OF MICHIGAN
RONALD C. PREVOST
PROFESSIONAL SURVEYOR
NO 24612
LICENSED PROFESSIONAL SURVEYOR

Signed by Ronald C. Prevost Date 11-11-94

Surveyor's Michigan License No. 24612

FORM APPROVED BY MICHIGAN STATE BOARD OF LAND SURVEYORS, JAN. 28, 1971
REVISED MAY 14, 1975
REVISED JAN., 1983