

# SURVEY & REMONUMENTATION

APR 26 1995

COMMISSION

## BAY COUNTY REMONUMENTATION

LAND CORNER RECORDATION CERTIFICATE  
Filing Requirement of Act 74, Mich. P.A. 1970

REGISTER OF DEEDS  
 BAY COUNTY, MICHIGAN  
 JAN 5 3 54 PM '95

RECORDED

For corners in  
Bay

(County)

Located In: Corner Code //

|                                 |                         |       |
|---------------------------------|-------------------------|-------|
| Public Land Survey              | T 14 N. R 5 E.          | C-3   |
|                                 | T _____ R _____         | _____ |
|                                 | T _____ R _____         | _____ |
|                                 | T _____ R _____         | _____ |
| Property Controlling in Section | S _____ T _____ R _____ | _____ |
|                                 | S _____ T _____ R _____ | _____ |
| Miscellaneous Property in Sec.  | S _____ T _____ R _____ | _____ |

**003 167**

Register of Deeds Stamp & File Number

Lot No. \_\_\_\_\_, Recorded Plat \_\_\_\_\_  
Private Claims \_\_\_\_\_

Ronald C. Prevost, in a field survey on October 26, 19 94, hereby certify that under requirements of P.A. 74, Michigan P.A. of 1970, the corner points mentioned in lines 1 and 2 above were in conformance with regulations and rules therefore as required in the current manual of survey instructions of the United States Department of the Interior, Bureau of Land Management or by a decree of a Court of Law and/or that the corner points mentioned in lines 3, 4 and 5 above were in conformance with the rules of the Michigan Board of Land Surveyors or by a Decree of a Court of Law; established, re-established, monumented, re-monumented, recovered, found as expressed below:

| A  | B  | C  | D  | E  | F  | G  | H | I | J | K | L | M |
|----|----|----|----|----|----|----|---|---|---|---|---|---|
| 2  | 6  | 5  | 4  | 3  | 2  | 1  |   |   |   |   |   |   |
| 3  |    | ●  |    |    |    |    |   |   |   |   |   |   |
| 4  | 7  | 8  | 9  | 10 | 11 | 12 |   |   |   |   |   |   |
| 5  |    |    |    |    |    |    |   |   |   |   |   |   |
| 6  | 18 | 17 | 16 | 15 | 14 | 13 |   |   |   |   |   |   |
| 7  |    |    |    |    |    |    |   |   |   |   |   |   |
| 8  | 19 | 20 | 21 | 22 | 23 | 24 |   |   |   |   |   |   |
| 9  |    |    |    |    |    |    |   |   |   |   |   |   |
| 10 | 30 | 29 | 28 | 27 | 26 | 25 |   |   |   |   |   |   |
| 11 |    |    |    |    |    |    |   |   |   |   |   |   |
| 12 | 31 | 32 | 33 | 34 | 35 | 36 |   |   |   |   |   |   |
| 13 |    |    |    |    |    |    |   |   |   |   |   |   |

**NOTE: Not more than 4 corners, all in the same town and range, may be recorded on this certificate.**

Description of original monument and accessories and/or subsequent restoration:

- C-3 Post Set by John Mullet, 1839  
Beech 7 S.44 W. 10 L  
Beech 14 N.44 E. 28 L  
LCRC L1 P537, Goss, 1972, P.K. Nail over Iron.  
LCRC L2 P606, Hughes, 1989, Iron Mon. Box.  
M.D.O.T. Witness 1" Pipe.  
Recorded Surveys L1003 P943, L656 P150, L824 P711, L968 P466, L1226 P675, L998 P434, L1150 P721, L687 P173, L672 P217, L921 P573, L1135 P838, L1159 P90, L850 P39.


Description of corner evidence found and/or method applied in restoring or reestablishing corner:

- C-3 Found 1" Pipe in Mon. Box and Recorded Witnesses as follows:  
NW 82.9 L1 P537, 82.4 L2 P606, 82.94 M.D.O.T., SE Cor. Bldg. ( 82.45)  
SE 82.7 L1 P537, 82.3 L2 P606, NW Cor. Bldg. ( 82.40 )  
N.50°E. 48.25 L2 P606 Face P. Pole (48.28m)

APPROVED LAND CORNER  
P.A. 345 OF 1990 - Bay County  
Date 27 Oct 94  
MM  
Michael MacDonald P.S.  
County Representative

Description of monument for corner and accessories established to perpetuate locating the position of the corner:

- C-3 Placed 5/8" Re-rod, 2 1/2" Bay Co. Brass Cap in Existing Mon. Box 11-10-94 in location of 1" pipe found.  
Center Hyd. N.65°E. 67.74  
Set Bay Co. Tag E. Face P. Pole S.45°W. 46.85  
Set Bay Co. Tag SW Face Guy Pole N.50°E. 48.28  
NW Cor. Bldg. S.45°E. 82.40  
SE Cor. Bldg. N.40°W. 82.45

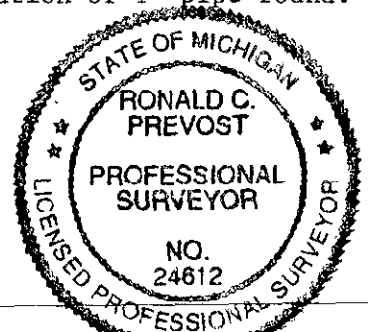

Signed by Ronald C. Prevost

Date 12-30-94

Surveyor's Michigan License No. 24612