SURVEY &
REMONUMENTATION

APR 2 6 1995

COMMISSION

BAY COUNTY REMONUMENTATION

LAND CORNER RECORDATION CERTIFICATE
Filing Requirement of Act 74, Mich. P.A. 1970

For corners in
Bay
(County)

		Located In:	Corner Code 11
1. Public Land Survey		T 14 N. R 5 E.	C-5
		T ____ R ____	
		T ____ R ____	
		T ____ R ____	
2. Property Controlling	S ____	T ____ R ____	
in Section	S ____	T ____ R ____	
3. Miscellaneous	S ____	T ____ R ____	
Property in Sec.	S ____	T ____ R ____	

JAN 9 3 54 PM '95
RECORDED

003 169

Register of Deeds Stamp & File Number

4. Lot No. _____, Recorded Plat _____
5. Private Claims _____

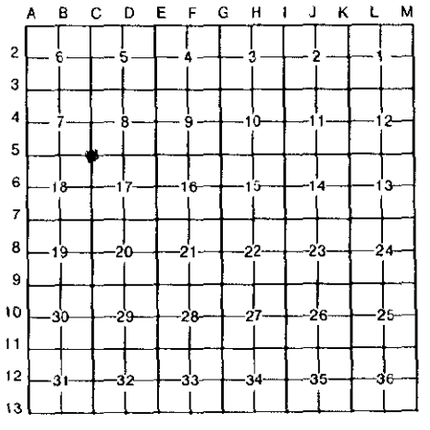

I, Ronald C. Prevost, in a field survey on October 26, 19 94, do hereby certify that under requirements of P.A. 74, Michigan P.A. of 1970, the corner points mentioned in lines 1 and 2 above were in conformance with regulations and rules therefore as required in the current manual of survey instructions of the United States Department of the Interior, Bureau of Land Management or by a decree of a Court of Law and/or that the corner points mentioned in lines 3, 4 and 5 above were in conformance with the rules of the Michigan Board of Land Surveyors or by a Decree of a Court of Law; established, re-established, monumented, re-monumented, recovered, found as expressed below:

NOTE: Not more than 4 corners, all in the same town and range, may be recorded on this certificate.

6. Description of original monument and accessories and/or subsequent restoration:

C-5 Post Set by John Mullet, 1839
Elm 14 S.31 W 18 L
B. Ash 20 N.55 E 24 L
LCRC L1 P281, Goss, 1972, Mon. Box.
LCRC L2 P607, Hughes, 1989, Boat Spike in Mon. Box.
Recorded Surveys L657 P282, L840 P660, L942 P597, L1185 P94, L1288 P988, L1315 P751.

7. Description of corner evidence found and/or method applied in restoring or reestablishing corner:

C-5 Found Boat Spike in Mon. Box and Recorded Witnesses as follows:
S.70°W. 78.0 Face P. Pole L2 P607 (78.02 m)
N.50°E. 81.8 Face P. Pole L2 P607 (81.8 m)
S.55°E. 36.75 M.B.T.-M.H. Cover L2 P607 (36.75 m)

APPROVED LAND CORNER
P.A. 345 OF 1990 - Bay County
Date 27 Oct 94
MM
Michael MacDonald P.S.
County Representative

8. Description of monument for corner and accessories established to perpetuate locating the position of the corner:

C-5 Set 5/8" Re-rod, 2½" Bay Co. Brass Cap in Existing Mon. Box in place of Boat Spike 11-10-94.
Face P. Pole S.70°W. 78.02
Face P. Pole N.50°E. 81.80
MBT M.H. Cover S.55°E. 36.75
In ℄ Bit. N. & S. and E. & W.

STATE OF MICHIGAN
RONALD C. PREVOST
PROFESSIONAL SURVEYOR
NO. 24612
LICENSED PROFESSIONAL SURVEYOR

Signed by Ronald C. Prevost Date 12-30-94

Surveyor's Michigan License No. 24612

FORM APPROVED BY MICHIGAN STATE BOARD OF LAND SURVEYORS, JAN. 28, 1971
REVISED MAY 14, 1975
REVISED JAN., 1983