

BAY COUNTY REMONUMENTATION  
LAND CORNER RECORDATION CERTIFICATE  
Filing Requirement of Act 74, Mich. P.A. 1970

JAN 9 10 02 AM '96

REGISTER OF DEEDS  
BAY COUNTY, MICHIGAN

For corners in  
Bay \_\_\_\_\_  
(County)

Located In: \_\_\_\_\_ Corner Code ## \_\_\_\_\_

1. Public Land Survey	T	14N	R	5E	D-13
	T	_____	R	_____	_____
	T	_____	R	_____	_____
	T	_____	R	_____	_____
2. Property Controlling in Section	S	_____	T	_____	R
	S	_____	T	_____	R
3. Miscellaneous Property in Sec.	S	_____	T	_____	R
	S	_____	T	_____	R

003 276

Register of Deeds Stamp & File Number

4. Lot No. \_\_\_\_\_, Recorded Plat \_\_\_\_\_  
5. Private Claims \_\_\_\_\_

I, Duane F. Ledy, in a field survey on December 29, 19 95, do hereby certify that under requirements of P.A. 74, Michigan P.A. of 1970, the corner points mentioned in lines 1 and 2 above were in conformance with regulations and rules therefore as required in the current manual of survey instructions of the United States Department of the Interior, Bureau of Land Management or by a decree of a Court of Law and/or that the corner points mentioned in lines 3, 4 and 5 above were in conformance with the rules of the Michigan Board of Land Surveyors or by a Decree of a Court of Law; established, re-established, monumented, re-monumented, recovered, found as expressed below:

A	B	C	D	E	F	G	H	I	J	K	L	M
2	6	5	4	3	2	1						
3												
4	7	8	9	10	11	12						
5												
6	18	17	16	15	14	13						
7												
8	19	20	21	22	23	24						
9												
10	30	29	28	27	26	25						
11												
12	31	32	33	34	35	36						
13												

NOTE: Not more than 4 corners, all in the same town and range, may be recorded on this certificate.

A. Description of original monument and accessories and/or subsequent restoration:

D-13  
No 1/4 corner set by GLO. River and island was meandered only. Standard line ran across river, set posts on Saginaw River banks at 27.50 chains and 61.67 chains from E-13. No evidence or record of this corner having been set. No L.C.R.C. recordings. No surveys of record using this corner.

B. Description of corner evidence found and/or method applied in restoring or reestablishing corner:

D-13  
Found no corner at D-13. Corner to be set at mid-point between C-13 and E-13 on a line from C-13 according to the section line established on surveys of record on Middle Grounds, Section 5.


Located Edmands irons and offset North 33 feet to Section line to establish corner.

Position accepted as best evidence of the position at which the corner should be set.

C. Description of monument for corner and accessories established to perpetuate locating the position of the corner:

D-13  
Set 5/8" x 24" rod and 2 1/2" Bay County brass cap in monument box. South - 27.30' to Nail & Tag in East side of 15" Box Elder North - 18.86' to Nail & Tag in East side of 18" Box Elder S 45°W - 37.17' to Nail & Tag in West side of 12" Aspen N 10°E - 12.64' to Nail & Tag in West side of 12" Aspen

APPROVED LAND CORNER  
P.A. 345 OF 1990 - Bay County  
Date 9 Nov 95  
MJM  
Michael MacDonald P.S.  
County Representative

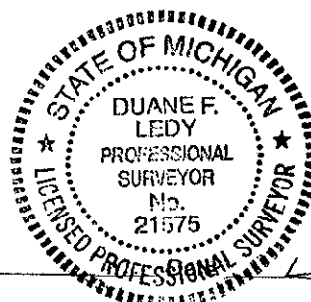

Signed by Duane F. Ledy  
Surveyor's Michigan License No. 21575