

SECTION

**BAY COUNTY REMONUMENTATION
LAND CORNER RECORDATION CERTIFICATE
Filing Requirement of Act 74, Mich. P.A. 1970**

For corners in

<u>BAY COUNTY</u> (County)	Located In:	Corner Code #
1. Public Land Survey	T <u>14N</u> R <u>5E</u>	<u>E-6</u>
	T _____ R _____	_____
	T _____ R _____	_____
	T _____ R _____	_____
2. Property Controlling in Section	S _____ T _____ R _____	_____
	S _____ T _____ R _____	_____
3. Miscellaneous Property in Sec.	S _____ T _____ R _____	_____
	S _____ T _____ R _____	_____

RECORDED

2000 JAN -7 P 2:00

Register of Deeds Stamp & File Number

Robert Francis MacFarlane
REGISTER OF DEEDS
BAY COUNTY, MICHIGAN

4. Lot No. _____, Recorded Plat _____

5. Private Claims _____

I, DALE L. WINECKE, in a field survey on OCTOBER 27, 1999 do hereby state that under requirements of P.A. 74, Michigan P.A. of 1970, the corner points mentioned in lines 1 and 2 above were in conformance with regulations and rules therefore as required in the current manual of survey instructions of the United States Department of the Interior, Bureau of Land Management or by a decree of a Court of Law and /or that the corner points mentioned in lines 3, 4 and 5 above were in conformance with the rules of the Michigan Board of Land Surveyors or by a Decree of a Court of Law; established, re-established, monumented, recovered, found as expressed below:

NOTE: Not more than 2 corners, all in the same Town and Range, may be recorded on this certificate.

A	B	C	D	E	F	G	H	I	J	K	L
1											
2	6		5		4		3		2		1
3											
4	7		8		9		10		11		12
5											
6	18		17	●	16		15		14		13
7											
8	19		20		21		22		23		24
9											
10	30		29		28		27		26		25
11											
12	31		32		33		34		35		36
13											

A. Description of original monument and accessories and/or subsequent restoration:

E-6
POST SET BY J. WAMPLER, 1821
6" B.OAK S32 1/2°W 29 LINKS
6" B.OAK N34°E 34 LINKS

- PLAT OF B F PIERCES ADDITION TO WEST BAY CITY, L. 3, P. 8, BAY COUNTY RECORDS
- PLAT OF KOCZENASZ SUBDIVISION, L. 5, P. 15, BAY COUNTY RECORDS
- PLAT OF SMITH STREET SUBDIVISION, L. 6, P. 23, BAY COUNTY RECORDS

B. Description of corner evidence found and/or method applied in restoring or reestablishing corner:


E-6
SEARCHED THE APPARENT LOCATION OF THE CORNER AND FOUND NO MONUMENTATION.

SET CORNER EAST FROM SE CORNER LOT 1 SMITH STREET SUBDIVISION AT RECORD DISTANCE 783.00'. VERIFIED NORTH ROW LINE FROM FOUND MONUMENTATION. SE CORNER OF LOT 1 ALSO FALLS ON THE E-W 1/4 LINE AS MONUMENTED.

POSITION ACCEPTED AS THE BEST EVIDENCE OF THE POSITION OF THE ORIGINAL CORNER.

C. Description of monument for corner and accessories established to perpetuate locating the position of the corner:

D-7 SET 5/8" X 24" REROD WITH BAY COUNTY REMONUMENTATION CAP IN MONUMENT BOX.
N80°E 37.29' TO NAIL AND TAG IN NW FACE UTILITY POLE.
N10°W 75.58' TO NAIL AND TAG IN SW FACE UTILITY POLE.
S70°W 53.27' TO NAIL AND TAG IN NORTH FACE 18" MAPLE.
N20°E 121.26' TO SW CORNER BRICK PLANTER BOX IN FRONT OF CHURCH.
NORTH 46.12' TO PK NAIL IN PHYSICAL CENTERLINE OF STATE STREET AND SMITH STREET.
S65°W 67.00 TO NE CORNER BRICK HOUSE #101.

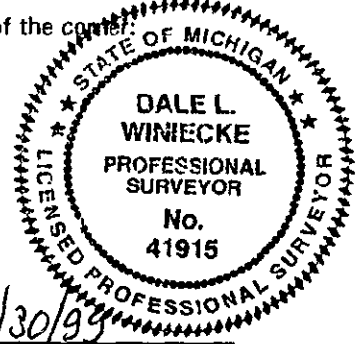

Signed by Dale Winecke Date 12/30/99
Surveyor's Michigan License No. 41915

APPROVED LAND CORNER
P.A. 345 OF 1990 - Bay County
Date 09/30/99
MM
Michael MacDonald P.S.
County Representative

005 05