

MAY 20 1997

COMMISSION

BAY COUNTY REMONUMENTATION
LAND CORNER RECORDATION CERTIFICATE
Filing Requirement of Act 74, Mich. P.A. 1970

003 317

For corners in

| Bay | Located In: | Corner Code # |
|------------------------------------|-------------|---------------|
| (County) | | |
| 1. Public Land Survey | T14N R 5E | E-12 |
| | T R | |
| | T R | |
| | T R | |
| 2. Property Controlling in Section | S T R | |
| | S T R | |
| 3. Miscellaneous Property in Sec. | S T R | |
| | S T R | |

REGISTER OF DEEDS
 BAY COUNTY, MICHIGAN
 Dec 27 2 24 PM '96
 RECORDED
 Register of Deeds Stamp & File Number

4. Lot No. _____, Recorded Plat _____
 5. Private Claims _____

I, Ronald C. Prevost, in a field survey on Nov., 1996 do hereby state that under requirements of P.A. 74, Michigan P.A. of 1970, the corner points mentioned in lines 1 and 2 above were in conformance with regulations and rules therefore as required in the current manual of survey instructions of the United States Department of the Interior, Bureau of Land Management or by a decree of a Court of Law and /or that the corner points mentioned in lines 3, 4 and 5 above were in conformance with the rules of the Michigan Board of Land Surveyors or by a Decree of a Court of Law; established, re-established, monumented, recovered, found as expressed below:

NOTE: Not more than 2 corners, all in the same town and range, may be recorded on this certificate.

| | A | B | C | D | E | F | G | H | I | J | K | L | M |
|----|----|---|----|---|----|---|----|---|----|---|----|---|---|
| 1 | | | | | | | | | | | | | |
| 2 | 6 | | 5 | | 4 | | 3 | | 2 | | 1 | | |
| 3 | | | | | | | | | | | | | |
| 4 | 7 | | 8 | | 9 | | 10 | | 11 | | 12 | | |
| 5 | | | | | | | | | | | | | |
| 6 | 18 | | 17 | | 16 | | 15 | | 14 | | 13 | | |
| 7 | | | | | | | | | | | | | |
| 8 | 19 | | 20 | | 21 | | 22 | | 23 | | 24 | | |
| 9 | | | | | | | | | | | | | |
| 10 | 30 | | 29 | | 28 | | 27 | | 26 | | 25 | | |
| 11 | | | | | | | | | | | | | |
| 12 | 31 | | 32 | | 33 | | 34 | | 35 | | 36 | | |
| 13 | | | | | | | | | | | | | |

A. Description of original monument and accessories and/or subsequent restoration:

E-12
 Set post at 40.00 chains North of E-13; June, 1839, J. Mullet
 9" Elm-S61°E, 2 links
 16" Lynn-S33 1/2°W, 36 links

No L.C.R.C.'s or Recorded Surveys.

Some information from old recorded plat, "Map of Daglish Division of Portsmouth Michigan" Liber 2, Page 45. Shows location being 2600 feet South of E-11. No other information available.

B. Description of corner evidence found and/or method applied in restoring or reestablishing corner:


E-12
 Set temporary point at split on true line between E-13 and E-11. Found 1" pipe 2.86 feet east and 8.26 feet south of temporary point. The found pipe may very well be the corner due to the fact that it does not fit with any platted corners or lines. A 10" tree has grown around the pipe not allowing for its removal.

Found 1" pipe accepted as best evidence of original position.

APPROVED LAND CORNER
 P.A. 345 OF 1990 - Bay County
 Date 21 Nov 96
HJM
 Michael MacDonald P.S.
 County Representative

C. Description of monument for corner and accessories established to perpetuate locating the position of the corner:

E-12
 Set 5/8" rod with Bay County Remonumentation Cap inside 1" pipe
 S 70° W 26.48' to SE corner of house #505
 East 0.87' to set nail in South side 10" tree
 NW 70.50' to set P.K. nail in West side Power Pole
 SW 39.37' to set P.K. nail in East side Power Pole

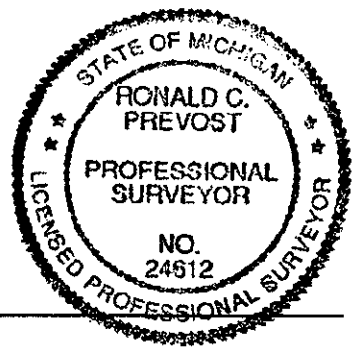

Signed by Ronald C. Prevost
 Surveyor's Michigan License No. 24612

Date 12-23-96