

RF

DEC 28 2000

BAY COUNTY REMONUMENTATION 1999

RECORDED

LAND CORNER RECORDATION CERTIFICATE
Filing Requirement of Act 74, Mich. P.A. 1970

SECTION

For corners in

Form with fields: Bay (County), Located In: Hampton Twp., Corner Code #, 1. Public Land Survey, 2. Property Controlling, 3. Miscellaneous Property in Sec.

1999 DEC 28 P 1:00
Barbara Toney Old Person
REGISTER OF DEEDS
BAY COUNTY, MICHIGAN
Register of Deeds Stamp & File Number

4. Lot No. , Recorded Plat
5. Private Claims

I, Roger P. Mahoney, in a field survey on 10-25, 1999 do hereby state that under requirements of P.A. 74, Michigan P.A. of 1970, the corner points mentioned in lines 1 and 2 above were in conformance with regulations and rules therefore as required in the current manual of survey instructions of the United States Department of the Interior, Bureau of Land Management or by a decree of a Court of Law and /or that the corner points mentioned in lines 3, 4 and 5 above were in conformance with the rules of the Michigan Board of Land Surveyors or by a Decree of a Court of Law; established, re-established, monumented, recovered, found as expressed below:

Grid table with columns A-L and rows 1-13. A dot is present in cell K-3.

NOTE: Not more than 2 corners, all in the same town and range, may be recorded on this certificate.

A. Description of original monument and accessories and/or subsequent restoration:


K-3 Post set by Wampler, 1821. Found 2" pipe bent over from old survey 1932± - LCRC Ankrom, 1986 - set re-rod and cap at base. Found 1/2" re-rod - LCRC Hughes, 1989.

B. Description of corner evidence found and/or method applied in restoring or reestablishing corner:

K-3 Found 1/2" re-rod with cap #21265 (Ankrom) from witness on LCRC by Ankrom and Hughes. Accepted the 1/2" re-rod as the best available evidence of the position of the original corner.

C. Description of monument for corner and accessories established to perpetuate locating the position of the corner:

K-3 Replaced 1/2" re-rod w/cap #21265 with 5/8" rebar and Bay County remon cap stamped #41105. N.30°W. - 54.15' nail and tag in SW. face S. p. pole. (rec'd 54.15'). S.25°E. - 24.62' - PK nail NW. corner R.R. tie (upright)(rec'd 24.30'). East - 90.00' - ⌘ Drive (set mag nail)(rec'd 90.0'± to ⌘ of drive). S.15°E. - 99.95' - NW. corner conc. meter pit.

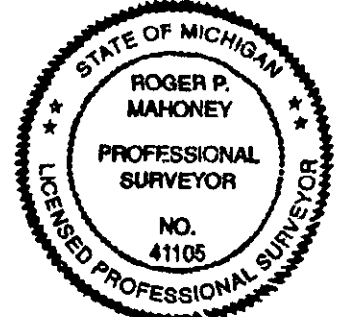

Signed by Roger P. Mahoney

Date 12-22-99

Surveyor's Michigan License No. 41105

APPROVED LAND CORNER
P.A. 345 OF 1990 - Bay County
Date 6-21-99
Michael MacDonald P.S.
County Representative

004 275