

BAY COUNTY REMONUMENTATION

LAND CORNER RECORDATION CERTIFICATE Filing Requirement of Act 74, Mich. P.A. 1970

For corners in Bay
(County)

Located In:


Corner Code #

1. Public Land Survey	14 N.	5 E.	K-8
	T	R	_____
	T	R	_____
	T	R	_____
	T	R	_____
2. Property Controlling in Section	S	T	_____
	S	T	_____
3. Miscellaneous Property in Section	S	T	_____
	S	T	_____

4. Lot No. _____, Recorded Plat _____
5. Private Claims _____

REGISTER OF DEEDS
 BAY COUNTY, MICHIGAN
 DEC 22 12 36 PM '95
 RECORDED
 003 238
 Register of Deeds Stamp & File Number

Ronald C. Prevost, in a field survey on September 28, 1995, do hereby certify that under requirements of P.A. 74, Michigan P.A. of 1970, the corner points mentioned in lines 1 and 2 above were in conformance with regulations and rules therefore as required in the current manual of survey instructions of the United States Department of the Interior, Bureau of Land Management or by a decree of a Court of Law and/or that the corner points mentioned in lines 3, 4 and 5 above were in conformance with the rules of the Michigan Board of Professional Surveyors or by a Decree of a Court of Law; established, re-established, monumented, re-monumented, recovered, found as expressed below:

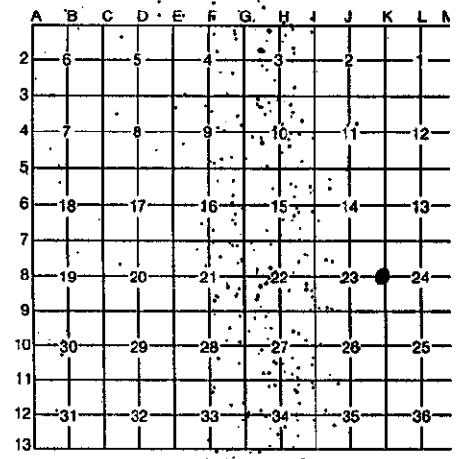

NOTE: Not more than 4 corners, all in the same town and range, may be recorded on this certificate.

A. Description of original monument and accessories and/or subsequent restoration:

K-8 Post Set by Wampler 1821
W Oak 20" N.71°E. 19 L
Hickory 10" N.85°W. 29 L
No LCRC
Not shown on recorded surveys


B. Description of corner evidence found and/or method applied in restoring or reestablishing corner:

K-8 Nothing found, corner established at single proportion location between Section corner common to Sections 23, 24, 25 & 26 and the reserve corner on the line between Sections 23 & 24.
Single proportion location accepted as best position for corner.

APPROVED LAND CORNER
P.A. 345 OF 1890 - Bay County
Date 08 Sept 95
M.M.
Michael MacDonald P.S.
County Representative

C. Description of monument for corner and accessories established to perpetuate locating the position of the corner:

K-8 Set Mon. Box with 5/8" X 24" Re-Bar & 2 3/4" Bay Co. Brass Cap on 10-11-95
Bay Co. Tag in E. Face 30" Ash West 40.35
Bay Co. Tag in Face P. & T. Pole N.15°W. 55.91
Bay Co. Tag in Face P. Pole N.20°E. 75.36
Bay Co. Tag in Face P. Pole S.25°E. 51.42
South 2628.77 to corner K-9
North 785.34 to reserve corner

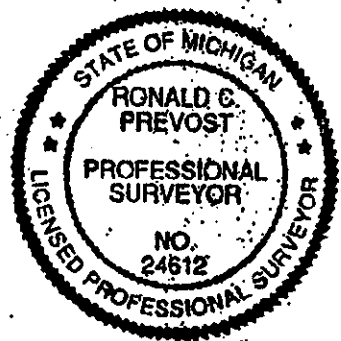

Signed by Ronald C. Prevost
24612

Date 12-8-95

Surveyor's Michigan License No. _____