

BAY COUNTY REMONUMENTATION

LAND CORNER RECORDATION CERTIFICATE Filing Requirement of Act 74, Mich. P.A. 1970

For corners in Bay

(County)

Located In:

Corner Code #

1. Public Land Survey	T	14 N.	R	5 E.	K-9
	T		R		
	T		R		
	T		R		
	T		R		
2. Property Controlling in Section	S	T	R		
	S	T	R		
3. Miscellaneous Property in Section	S	T	R		
	S	T	R		

4. Lot No. _____, Recorded Plat _____

5. Private Claims _____

REGISTER OF DEEDS
 BAY COUNTY, MICHIGAN

DEC 22 12:38 PM '95


RECORDED

003 239

Register of Deeds Stamp & File Number

I, Ronald C. Prevost, in a field survey on June 22, 19 95, do hereby certify that under requirements of P.A. 74, Michigan P.A. of 1970, the corner points mentioned in lines 1 and 2 above were in conformance with regulations and rules therefore as required in the current manual of survey instructions of the United States Department of the Interior, Bureau of Land Management or by a decree of a Court of Law and/or that the corner points mentioned in lines 3, 4 and 5 above were in conformance with the rules of the Michigan Board of Professional Surveyors or by a Decree of a Court of Law; established, re-established, monumented, re-monumented, recovered, found as expressed below:

NOTE: Not more than 4 corners, all in the same town and range, may be recorded on this certificate.

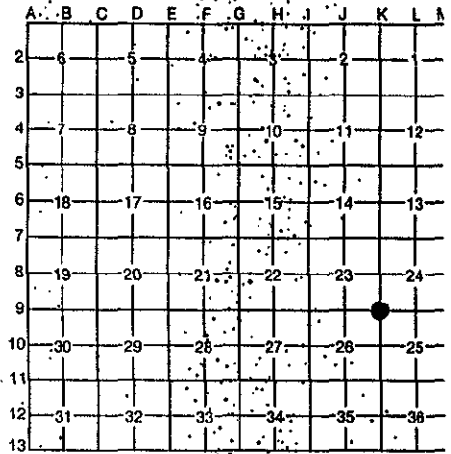

A. Description of original monument and accessories and/or subsequent restoration:

K-9 Post Set by Wampler 1821
 W Oak 18" N.74 1/2°W. 10 L
 Elm 10" N.61°E. 18L
 LCRC, L1 P219 - 3/4" Iron Bar in Mon. Box.
 Several recorded surveys indicating Mon. Box. No witnesses
 Old Co. Surveyors record (Monument in pavement) No witnesses given
 Shown as found monument on highway r/w map


B. Description of corner evidence found and/or method applied in restoring or reestablishing corner:

K-9 Found 3/4" Bar in Mon. Box.
 Monument accepted as the best available evidence of the position of the original corner.

APPROVED LAND CORNER
 P.A. 345 OF 1990 - Bay County
 Date 22 June 95
M.H.
 Michael MacDonald P.S.
 County Representative

C. Description of monument for corner and accessories established to perpetuate locating the position of the corner:

K-9 Replaced 3/4" Bar with 5/8" X 24" Re-Bar with 2 3/4" Bay Co. Brass Cap in existing Mon. Box. on 7-17-95. Also installed 3" Adapter Lift Ring & New Cover.
 Nail E. Side U.P. N.45°W. 49.94
 Nail & M.S.H.D. Tag N.W. Face U.P. N.40°E 56.52
 Nail & M.S.H.D. Tag W. Face U.P. S.45°E. 59.53 (59.50 Rec.)
 Nail & M.S.H.D. Tag N.W. Face U.P. S.45°W. 61.57 (61.60 Rec.)

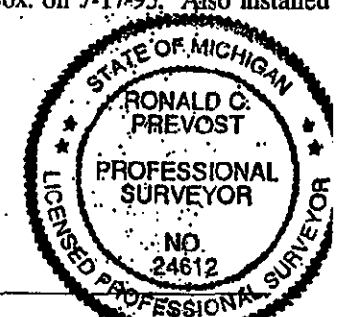

Signed by Ronald C. Prevost
 Surveyor's Michigan License No. 24612

Date 12-8-95