

BAY COUNTY REMONUMENTATION

LAND CORNER RECORDATION CERTIFICATE

Filing Requirement of Act 74, Mich. P.A. 1970

For corner Bay
(County)

Located In:

Corner Code #

		14 N.	5 E.	K-10
1. Public Land Survey	T	_____	R	_____
	T	_____	R	_____
	T	_____	R	_____
	T	_____	R	_____
2. Property Controlling in Section	S	_____	T	_____
	S	_____	T	_____
3. Miscellaneous	S	_____	T	_____
Property in Section	S	_____	T	_____

4. Lot No. _____, Recorded Plat _____
5. Private Claims _____

I, Ronald C. Prevost, in a field survey on June 22, 1995, do hereby certify that under requirements of P.A. 74, Michigan P.A. of 1970, the corner points mentioned in lines 1 and 2 above were in conformance with regulations and rules therefore as required in the current manual of survey instructions of the United States Department of the Interior, Bureau of Land Management or by a decree of a Court of Law and/or that the corner points mentioned in lines 3, 4 and 5 above were in conformance with the rules of the Michigan Board of Professional Surveyors or by a Decree of a Court of Law; established, re-established, monumented, re-monumented, recover: found as expressed below:

NOTE: Not more than 4 corners, all in the same town and range, may be recorded on this certificate.

A. Description of original monument and accessories and/or subsequent restoration:

K-10 Post Set by Wampler 1821
Elm 16" N.39 1/2°W. 15 L
Elm 12" S.73°E. 17 L
LCRC, L1, P219 - 3/4" Pipe Mon. Box - Soltis - 1972
Co. Surveyors Records 3/4" Iron
Recorded Surveys L696 P412, L910 P774, L696 P79, L940 P517

B. Description of corner evidence found and/or method applied in restoring or reestablishing corner:

K-10 Found 3/4" Pipe capped #18999 in Mon. Box, also 1/2" Rod in Mon. Box 0.20' N. of 3/4" Holding with 3/4" Pipe Location
Monument accepted as the best available evidence of the position of the original corner.

APPROVED LAND CORNER
P.A. 345 OF 1990 - Bay County
Date 22 June 95
MJM
Michael MacDonald P.S.
County Representative

C. Description of monument for corner and accessories established to perpetuate locating the position of the corner:


K-10 Replaced 3/4" Pipe with 5/8" X 24" Rc-Bar with 2 3/4" Bay Co. Brass Cap in existing Mon. Box. on 7-13-95.
Nail & Kraft Eng. Cap W Face P.P. S.45°E. 48.89
Ctr. Top Project Marker S.40°E 58.65
Nail & Kraft Eng. Cap N. Face P.P. S.45°W. 59.03 (59.05 Rec.)
P.K. Nail S. Face T. P. N.45°W. 60.24 (60.23 Rec.)
Ctr. Hyd. N.45°E. 50.86

REGISTER OF DEEDS
 BAY COUNTY, MICHIGAN
 DEC 22 12:38 PM '95
 RECORDED
 003 240
 Register of Deeds Stamp & File Number

A	B	C	D	E	F	G	H	I	J	K	L	M
2	6	5	4	3	2	1						
3												
4	7	8	9	10	11	12						
5												
6	18	17	16	15	14	13						
7												
8	19	20	21	22	23	24						
9												
10	30	29	28	27	26	25						
11												
12	31	32	33	34	35	36						
13												

Signed by Ronald C. Prevost
24612

Date 12-8-95

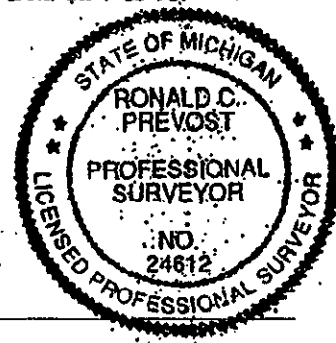

Surveyor's Michigan License No. _____