

DEC 28 2000

LAND CORNER RECORDATION CERTIFICATE
Filing Requirement of Act 74, Mich. P.A. 1970

SECTION

For corners in

Form with fields for Bay (County), Located In: Hampton Twp., Corner Code #, and numbered sections 1-3 for Public Land Survey, Property Controlling, and Miscellaneous Property in Sec.

1999 DEC 28 P 1:00

Barbara Teresa Durfee
REGISTER OF DEEDS
BAY COUNTY, MICHIGAN

Register of Deeds Stamp & File Num

4. Lot No. , Recorded Plat
5. Private Claims

I, Roger P. Mahoney, in a field survey on 12-21, 1999 do hereby state that under requirements of P.A. 74, Michigan P.A. of 1970, the corner points mentioned in lines 1 and 2 above were in conformance with regulations and rules therefore as required in the current manual of survey instructions of the United States Department of the Interior, Bureau of Land Management or by a decree of a Court of Law and/or that the corner points mentioned in lines 3, 4 and 5 above were in conformance with the rules of the Michigan Board of Land Surveyors or by a Decree of a Court of Law; established, re-established, monumented, recovered, found as expressed below:

Grid table with columns A-K and rows 1-13, containing numbers 6 through 35.

NOTE: Not more than 2 corners, all in the same town and range, may be recorded on this certificate.

A. Description of original monument and accessories and/or subsequent restoration:

M-3 Post set by Wampler, 1821. Iron - Consumers Power witnesses sheet - No witnesses given - No date. No further evidence of restoration.


B. Description of corner evidence found and/or method applied in restoring or reestablishing corner:

M-3 No corner found. Set temporary point on a line extended North from M-4 through irons found on East line Section 12 as shown on 1958 Consumers Power Company Drawing #S-F 16227. Distance North of M-4 was determined by doubling the 1/8 line distance as shown on Consumers Power drawing and verified by measuring to corners found on the East Section Line which checked very close to dimension shown on Consumers Power Company drawing. Point falls at bottom of slope for East bank of drainage ditch.

Accepted the temporary point as the best available evidence of the position of the original corner.

C. Description of monument for corner and accessories established to perpetuate locating the position of the corner:

M-3 Replace temporary point with 5/8" rod and Bay County remon cap stamped 41105. N.45°E. - 44.80' - set 3/4" pipe on W. edge gravel trail. S.45°E. - 33.51' - set 3/4" pipe on W. edge gravel trail. S.11°E. - 65.07' N&T W. face twin 5" Poplar. N.76°E. - 55.94' N&T S. face 30" Poplar. West - 6'± - E. Edge of water of large drainage ditch.

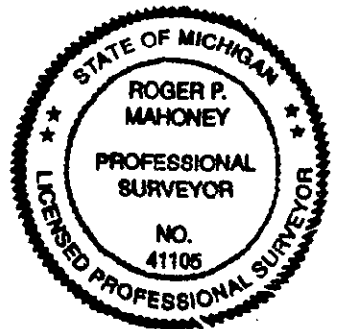

Signed by Roger P. Mahoney
Roger P. Mahoney

Date 12-22-99

Surveyor's Michigan License No. 41105

APPROVED LAND CORNER
P.A. 345 OF 1990 - Bay County
Date 12-20-99
Michael MacDonald P.S.
County Representative

004 283